


WELL PLUGGING RECORD

Give All Information Completely
Make Required Affidavit
Mail or Deliver Report to:
Conservation Division
State Corporation Commission
800 Westing Building
Wichita, Kansas

Barton County. Sec. 1 Twp. 20 Rge. 11W (W)

Location as "NE/CNW $\frac{1}{4}$ SW $\frac{1}{4}$ " or footage from lines NE SE SE
Lease Owner Courtney B. Davis
Lease Name Stackel Well No. 6
Office Address 521 Union National Bank Bldg., Wichita, Kansas
Character of Well (completed as Oil, Gas or Dry Hole) Abandoned oil well
Date well completed March 3, 1937 19
Application for plugging filed May 6, 1950 (verbal) 19
Application for plugging approved May 8, 1950 19
Plugging commenced May 7, 1950 19
Plugging completed May 13, 1950 19
Reason for abandonment of well or producing formation no longer profitable to produce

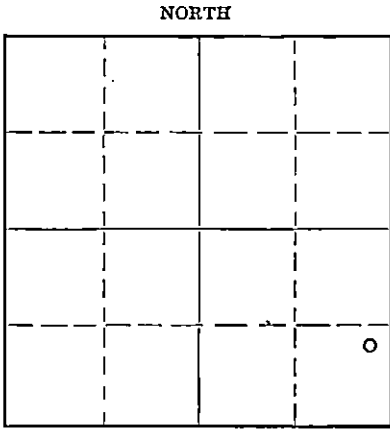

Locate well correctly on above Section Plat

If a producing well is abandoned, date of last production 19
Was permission obtained from the Conservation Division or its agents before plugging was commenced? Yes

Name of Conservation Agent who supervised plugging of this well C. D. Stough
Producing formation Depth to top Bottom Total Depth of Well 3284 Feet
Show depth and thickness of all water, oil and gas formations.

OIL, GAS OR WATER RECORDS

CASING RECORD

Formation	Content	From	To	Size	Put In	Pulled Out
				12 $\frac{1}{2}$ "	110	

Describe in detail the manner in which the well was plugged, indicating where the mud fluid was placed and the method or methods used in introducing it into the hole. If cement or other plugs were used, state the character of same and depth placed, from feet to feet for each plug set.

110 feet of 12 $\frac{1}{2}$ inch surface pipe circulated with cement. 7" casing set at 3273 feet. Plugged back to 3080 feet with cement, lane wells plug and chat. Dumped 6 sacks of cement at 3080 feet. Shot off and pulled the 7 inch casing. Mud to 150 feet. Set rock bridge and 25 sacks of cement at 150 feet. Mud to 30 feet. Bridge and 10 sacks of cement at the surface.

RECEIVED
STATE CORPORATION COMMISSION
SEP 29 1950
CONSERVATION DIVISION
Wichita, Kansas

(If additional description is necessary, use BACK of this sheet)
Correspondence regarding this well should be addressed to Courtney B. Davis,
Address 521 Union National Bank Bldg.,
Wichita, Kansas

STATE OF KANSAS, COUNTY OF SEDGWICK, ss.
(employee of owner) or (owner or operator) of the above-described well,
being first duly sworn on oath, says: That I have knowledge of the facts, statements, and matters herein contained and the log of the above-described well as filed and that the same are true and correct. So help me God.

(Signature) Courtney B. Davis
521 Union National Bank Bldg., Wichita, Kans.
(Address)

SUBSCRIBED AND SWORN to before me this 28th day of September 1950
Edward S. Meeder Notary Public.

PLUGGING
FILE SEC 4 T 20 R 10
BOOK PAGE 4 LINE 34

Steckel Well No. 6

SW/4 Sec. 1, Twp. 20, Range 11 W
Barton County, Kansas

Drilled for: Courtney B. Davis
Drilled by: Rose Spring Drilling Company

Casing Record

12 1/2" OD 110'
7" OD 3273'

Drilling Commenced: February 3, 1937
Drilling Completed: March 3, 1937

*Mr. Stegall Co.
© H. B. King
Ph.
Bart. Co.*

<u>FORMATION</u>	<u>DEPTH</u>
hard shell	110
red bed	500
shale & shells	935
shale & lime	1065
shale & shells	1300
lime	1540
lime & shale	1615
lime	1730
shale & lime	1910
lime	1955
shale & shells	2040
shale & lime	2110
shale & shells	2305
shale & lime	2308
lime	2865
lime & shale	3035
shale & shells	3055
shale & lime	3115
lime	3140
shale	3170
shale & shells	3250
shale	3265
lime	3284 TOTAL DEPTH

STATE OF KANSAS
COUNTY OF SEDGWICK SS

I, the undersigned, being duly sworn on oath, state that the above and within statement is a true and correct record and log of the well drilled on the location above described, to the best of my knowledge and belief.

W. M. Serafin

Subscribed and sworn to before me this 4th day of March 1937.

Joseph English

RECEIVED
STATE CORPORATION COMMISSION

Notary Public

SEP 29 1950

CONSERVATION DIVISION
Wichita, K

My Commission Expires --

2-01-1-1937

PLUGGING
FILE SEC L-170-PLUG
BOOK PAGE 4 LINE 34

R