


WELL PLUGGING RECORD

Give All Information Completely  
Make Required Affidavit  
Mail or Deliver Report to:  
Conservation Division  
State Corporation Commission  
800 Bittling Building  
Wichita, Kansas

NORTH

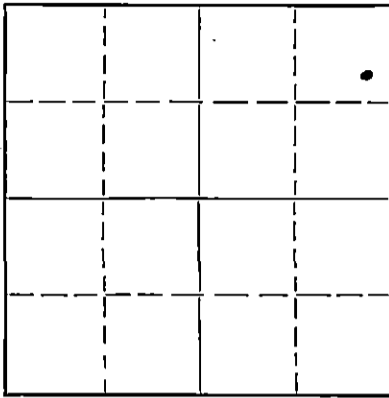

Locate well correctly on above  
Section Flat

Barton County. Sec. 1 Twp. 20S Rge. 11 (E) 11 (W)  
Location as "NE/CNW $\frac{1}{4}$ SW $\frac{1}{4}$ " or footage from lines SE/NE/NE  
Lease Owner Gulf Oil Corporation  
Lease Name L. A. Steckel Well No. 2  
Office Address Box 661, Tulsa 2, Oklahoma  
Character of Well (completed as Oil, Gas or Dry Hole) Oil  
Date well completed September 9 1935  
Application for plugging filed 19    
Application for plugging approved 19    
Plugging commenced May 9 1951  
Plugging completed May 13 1951  
Reason for abandonment of well or producing formation Depleted  
If a producing well is abandoned, date of last production April 30 1951  
Was permission obtained from the Conservation Division or its agents before plugging was commenced? Yes

Name of Conservation Agent who supervised plugging of this well Mr. Eldon Petty 3275'  
Producing formation Kansas City Lime Depth to top 2990' Bottom 3175' Total Depth of Well 3064 PB Feet  
Show depth and thickness of all water, oil and gas formations.

OIL, GAS OR WATER RECORDS

CASING RECORD

Formation	Content	From	To	Size	Put In	Pulled Out
				10"	150'	0
				6-5/8"	3258'	2586'

Describe in detail the manner in which the well was plugged, indicating where the mud fluid was placed and the method or methods used in introducing it into the hole. If cement or other plugs were used, state the character of same and depth placed, from \_\_\_\_\_ feet to \_\_\_\_\_ feet for each plug set.  
Crushed rock placed from 3064' to 3000'. 6 sacks cement dumped at 3000'. Hole mudded to 200'. Crushed rock bridge set at 200'. 20 sacks cement dumped on bridge at 200'. Hole mudded to 30' and capped with 10 sacks of cement.

RECEIVED  
STATE CORPORATION COMMISSION  
MAY 24 1951  
CONSERVATION DIVISION  
Wichita, Kansas

(If additional description is necessary, use BACK of this sheet)  
Correspondence regarding this well should be addressed to Mr. S. G. Sanderson  
Address Box 661  
Tulsa 2, Oklahoma

STATE OF Kansas, COUNTY OF Rice, SS.  
H. H. Wright (employee of owner) or (owner or operator) of the above-described well,  
being first duly sworn on oath, says: That I have knowledge of the facts, statements, and matters herein contained and the log of the above-described well as filed and that the same are true and correct. So help me God.

(Signature) H. H. Wright  
Box 544 - Chase, Kansas  
(Address)

SUBSCRIBED AND SWORN TO before me this 23rd day of May, 1951

My commission expires April 14, 1952  
Sam Council Notary Public.

PLUGGING  
FILE SEC L T 20 R 110  
BOOK 82 LINE 33

# WELL RECORD

15.009.14229.0000

WELL NO. **2** LEASE **L. A. Steckel** COMPANY **Gypsy Oil Company** AUTH. **K-2142**  
 DATE—Drilling Began **8-10-35** Well Completed **9-9-35** First Production **9-5-35**

SHOT—Date With Quarts—From To By  
 SAND RECORD **Siliceous lime - 3258' to 3275'** Total Depth - **3275'**

INITIAL PRODUCTION\* **"P" 1565\* Oil, No water (9/11)**

### CASING RECORD

Size	Wt.	Thd.	Class	Make	Run	Sacks-Cement	Pounds Cal. Chlo.	Pulled	Left In
10"	40	8	?	?	150'	100	200		150'
8-5/8"	24	10	SH	*SSEW	3258'	80			3258'
*(8-5/8" - 15 jts. Lapweld steel on bottom).									

S- **1** T- **20S** R- **11W**


(\* ) Best Day; "F", Flowing Naturally; "L", Air-Gas Lift; "S", Swabbing; "P", Pumping.  
 \* "P" 1875 Oil, no water, 10/8/35, with permanent pumping equipment. Elevation - **1762'**

Sandy limestone  
 Broken lime & shale  
 Broken lime  
 Shale  
 Lime  
 Shale & lime  
 Shale & shells  
 Broken lime  
 Shale  
 Shale & shells  
 Lime  
 Broken lime & shale  
 Lime  
 Broken lime  
 Shale  
 Lime, K. G.  
 Shale  
 Lime  
 Lime & shale streaks  
 Lime, Siliceous

**RECEIVED**  
 STATE CORPORATION COMMISSION  
 JUN 29 1951  
 CONSERVATION DIVISION  
 Wichita, Kansas

**PLUGGING**  
 FILE SEC- 1 T 20 R 11W  
 BOOK PAGE 97 LINE 27  
 82-33

12-000-14229.0000

# WELL RECORD

WELL NO. LEASE COMPANY  
 DATE—Drilling Began 9-10-38 Well Completed 9-2-38  
 SHOT—Date With Quarts—From To  
 SAND RECORD FORMATION  
 INITIAL PRODUCTION\* 1888\* OIL, no water (0/1)

Soil	10	CASING RECORD				
Sand & gravel	55	Size	Wt.	Thd.	Class	Make
Sand shells	45	Run	Comp.	Pounds	Pulled	Lat. In
Sand, shale & shells	100					
Shale & shells	150					
Shale & red bed	373					
Red bed & shells	543					
Shale & shells	1001					
Shale	1290					
Shale & shells	1360					
Broken lime	1445					
Shale & shells	1475					
Broken lime	1495					
Shale	1531					
Shale & shells	1640					
Sandy lime	1642					
Broken lime & shale	1705					
Broken lime	1735					
Shale	1810					
Lime	1843					
Shale & lime	1910					
Shale & shells	1990					
Broken lime	2075					
Shale	2165					
Shale & shells	2334					
Lime	2425					
Broken lime & shale	2460					
Lime	2825					
Broken lime	2940					
Shale	2955					
Lime, K. C.	3165					
Shale	3175					
Lime	3256					
Lime & shale streaks	3258					
Lime, Siliceous	3275', T. D.					

RECEIVED  
 STATE COMMISSION  
 JUN 2 1938  
 CONSERVATION DIVISION  
 WICHITA, KANSAS

PLUGGING  
 JUN 21 1938  
 87-33