

STATE OF KANSAS
STATE CORPORATION COMMISSION


WELL PLUGGING RECORD

Give All Information Completely
Make Required Affidavit
Mail or Deliver Report to:
Conservation Division
State Corporation Commission
800 Bittling Building
Wichita, Kansas

Barton County, Sec. 1 Twp. 20S Rge. (X) 11 (W)

Location as "NE/CNW $\frac{1}{4}$ SW $\frac{1}{4}$ " or footage from lines 330' WEL & 990' NSL - NE/4
Lease Owner Gulf Oil Corporation
Lease Name L. A. Steckel Well No. 6
Office Address Box 661 - Tulsa 2, Oklahoma
Character of Well (completed as Oil, Gas or Dry Hole) Oil
Date well completed February 17, 19 36
Application for plugging filed 19
Application for plugging approved May 16 19 51
Plugging commenced May 2 19 51
Plugging completed May 8 19 51
Reason for abandonment of well or producing formation Depleted

NORTH

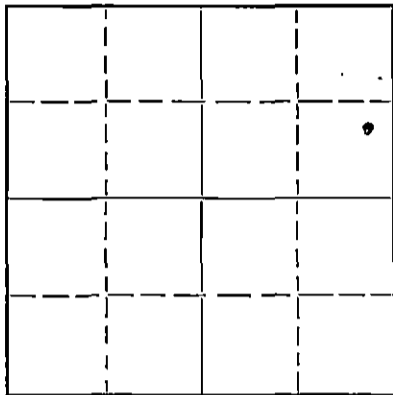

Locate well correctly on above Section Plat

If a producing well is abandoned, date of last production April 27 19 51
Was permission obtained from the Conservation Division or its agents before plugging was commenced? Yes

Name of Conservation Agent who supervised plugging of this well Mr. Eldon Petty 32701
Producing formation Kansas City Lime Depth to top 3005' Bottom 3085' Total Depth of Well 3228' PB Feet
Show depth and thickness of all water, oil and gas formations.

OIL, GAS OR WATER RECORDS

CASING RECORD

Formation	Content	From	To	Size	Put In	Pulled Out
				10"	156'	0'
				7"	3256'	2558'

Describe in detail the manner in which the well was plugged, indicating where the mud fluid was placed and the method or methods used in introducing it into the hole. If cement or other plugs were used, state the character of same and depth placed, from _____ feet to _____ feet for each plug set.

Crushed rock placed from 3228' to 3000'. 6 sacks cement dumped at 3000'. Hole mudded to 200'. Crushed rock bridge placed from 200' to 190'. 20 sacks cement dumped on bridge at 190'. Hole mudded to 30' and capped with 10 sacks of cement.

(If additional description is necessary, use BACK of this sheet)

Correspondence regarding this well should be addressed to Mr. S. G. Sanderson
Address Box 661
Tulsa 2, Oklahoma

STATE OF Kansas, COUNTY OF Rice, ss.
H. H. Wright (employee of owner) ~~operator~~ of the above-described well,
being first duly sworn on oath, says: That I have knowledge of the facts, statements, and matters herein contained and the log of the above-described well as filed and that the same are true and correct. So help me God.

(Signature) H. H. Wright
Box 544 - Chase, Kansas (Address)

SUBSCRIBED AND SWORN TO before me this 23rd day of May, 19 51

My commission expires April 14, 1952
Notary Public.

23-5091-s 8-50-10M

MAY 24 1951
CONSERVATION DIVISION
Wichita, Kansas

FILE SEC 1 1 70 R 11W
BOOK PAGE 82 LINE 25

15.009.14228.0000

WELL RECORD

WELL NO. **6** LEASE **L. A. Steckel** COMPANY **Gulf Oil Corporation Of Pennsylvania** AUTH. **K-2336**
 DATE—Drilling Began **1-19-36** Well Completed **2-17-36** First Production **2-17-36**
 SHOT—Date **Not shot** With _____ Quarts—From _____ To _____ By _____
 SAND RECORD **Siliceous Lime - 3252' to 3270'** **Total Depth - 3270'**
 INITIAL PRODUCTION* **"P" 1729 Oil, No Water. (2/19)**

CASING RECORD

S- **1** T- **20S** R- **11W**

Size	Wt.	Thd.	Class	Make	Run	Sacks Cement	Pounds Cal. Chlo.	Pulled	Left In
10"	40#	8	SH	SS	156'	100	300		156'
** 7"OD	24#	10	NEW	SS & SOLE	3256'	100			3256'
** (7" -	bottom 4 jts. seamless steel; remainder, South Chester Lapweld steel).								

(*) Best Day; "F", Flowing Naturally; "L", Air-Gas Lift; "S", Swabbing; "P", Pumping. **Elevation - 1761'**

3270' TOTAL DEPTH
 3268' Siliceous Lime
RECEIVED
 CORPORATION COMMISSION
 AUG 19 1932
 CONSERVATION DIVISION
 Wichita, Kansas

PLUGGING
 FILE SEC LT 20R 116
 BOOK PAGE 82 LINE 25