

WELL PLUGGING RECORD

Give All Information Completely  
Make Required Affidavit  
Mail Deliver Report to:  
Conservation Division  
State Corporation Commission  
800 Bittig Building  
Wichita, Kansas

Barton County. Sec. 1 Twp. 20S Rge. (E) 11(W)

Location as "NE/CNW/SW" or footage from lines NE NE NW; 330 FNL 330 FEL of NW/4

Lease Owner Magnolia Petroleum Company

Lease Name Meda STECKEL Well No. 1

Office Address Box 900, Dallas, Texas

Character of Well (completed as Oil, Gas or Dry Hole) Oil

Date well completed 3-14 19 56

Application for plugging filed 1-10 19 56

Application for plugging approved 1-10 19 56


Plugging commenced 2-7 19 56

Plugging completed 2-11 19 56

Reason for abandonment of well or producing formation Uneconomical to operate

If a producing well is abandoned, date of last production June 19 54

Was permission obtained from the Conservation Division or its agents before plugging was commenced? Yes

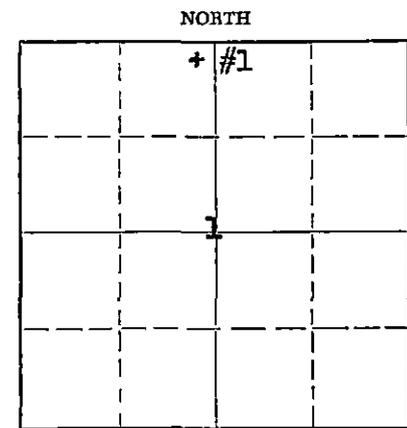

Locate well correctly on above Section Plat

Name of Conservation Agent who supervised plugging of this well R. M. Brundage

Producing formation Arbuckle Depth to top 3286 Bottom 3292 Total Depth of Well 3292 Feet

Show depth and thickness of all water, oil and gas formations.

OIL, GAS OR WATER RECORDS

CASING RECORD

FORMATION	CONTENT	FROM	TO	SIZE	PUT IN	PULLED OUT
<u>Arbuckle</u>	<u>Oil &amp; Wtr</u>	<u>3286'</u>	<u>3292'</u>	<u>12 1/2"</u>	<u>200'</u>	<u>None</u>
				<u>7"</u>	<u>3284'</u>	<u>1600'</u>

Describe in detail the manner in which the well was plugged, indicating where the mud fluid was placed and the method or methods used in introducing it into the hole. If cement or other plugs were used, state the character of same and depth placed, from \_\_\_\_\_ feet to \_\_\_\_\_ feet for each plug set.

Dump 5 sx cmnt on plug @ 3284', fill up to 3224', pull 1600' of 7" csg, mud hole to 185', set 5' rock bridge, mix & put in 30 sx cmnt to 135', fill hole w/mud to 25', set 5' rock bridge, mix & put in 15 sx cmnt, fill up to base of cellar.

(If additional description is necessary, use BACK of this sheet)

Name of Plugging Contractor Ace Pipe Pulling Co.  
Address Great Bend, Kansas

STATE OF KANSAS, COUNTY OF BARTON, ss. R. C. Brannin (employee of owner) or (owner or operator) of the above-described well, being first duly sworn on oath, says: That I have knowledge of the facts, statements, and matters herein contained and the log of the above-described well as filed and that the same are true and correct. So help me God.

(Signature) [Signature]

Box 770, Great Bend, Kansas  
(Address)

SUBSCRIBED AND SWORN TO before me this 21st day of February, 19 56

Harriett S. Kaiser

My commission expires Jan. 14, 1957

24-7968-5 3-53-20M

RECEIVED  
STATE CORPORATION COMMISSION

FEB 23 1956

CONSERVATION DIVISION  
Wichita, Kansas

PLUGGING  
FILE SEC 1 T 20 R 11W  
BOOK 16238 LINE 17

Meda STECKEL #1 (F&A)  
 NE NE NW  
 Sec 1-20S-11W  
 Barton County, Kansas  
 (Silica Field)

Elevation 1764' DF

Total Depth: 3292'

Drilling Commenced: 2-12-36  
 Drilling Completed: 3-14-36

Casing Record:

12 1/2" 40# Lapweld Put in: 200' Pulled: None Left In: 200' Cmntd w/225 sx  
 7" OD 2 1/4# Seamless Put In: 3284' Pulled: 1600' Left In: 1684' Cmntd w/250 sx

Formation Record:

<u>Formation</u>	<u>From</u>	<u>To</u>
Cellar	0	8
Clay	8	20
Sand	20	45
Shale & shells	45	192
Broken lime	192	200
12 1/2" csg set		200
Red bed	200	340
Shale & Shells	340	960
Salt	960	1120
Shale & shells	1120	1407
Shale & lime	1407	1505
Lime	1505	1625
Shale & shells	1625	1750
Lime & shale	1750	1785
Shale & shells	1785	2120
Shale & lime	2120	2195
Lime	2195	2240
Shale	2240	2286
Shale & Shells	2286	2375
Lime	2375	2615
Shale break	2615	2640
Lime	2640	2843
Shale	2843	3000
Shale & lime	3000	3060
Shale	3060	3090
Lime	3090	3273
Coring lime & shale	3273	3286
Top of Arbuckle	3284	
Reamed	3273	3284
7" OD csg set		3284
Standardized		
Arbuckle	3286	3292
Total Depth		3292

Note: No perforations, acid jobs or frac jobs on this well

RECEIVED  
 CONSERVATION DIVISION

FEB 27 1956

Plugging & Abandonment Record:

Plugging Commenced: 2-7-56 Ace Pipe Pulling Co.,  
 Plugging Completed: 2-11-56 Great Bend, Kansas

CONSERVATION DIVISION  
 Wichita, Kansas

History of Plugging: Dump 5 sx cmnt on plug @ 3244', fill up to 3224', pull 1600' of 7" csg, mud hole to 185', set 5' rock bridge, mix & put in 30 sx cmnt to 135', fill hole w/mud to 25', set 5' rock bridge, mix & put in 15 sx cmnt, fill up to base of cellar. Plugging supervised by R. M. Brundage, State Corp Comm District Plugging Supervisor.

**PLUGGING**  
 SEC 1-20-11W  
 PAGE 38 LINE 17