


STATE OF KANSAS
STATE CORPORATION COMMISSION

WELL PLUGGING RECORD

Give All Information Completely
Make Required Affidavit
Mail or Deliver Report to
Conservation Division
State Corporation Comm.
245 North Water
Wichita, KS 67202

Barton County. Sec. 1 Twp. 20 Rge. 11 E/W
Location as "NE/CNW $\frac{1}{4}$ SW $\frac{1}{4}$ " or footage from lines _____
150 W $\frac{1}{2}$ N/2 N/2 SW/4
Lease Owner Tiverton Petroleum, Inc.
Lease Name BRTNING Well No. 1
Office Address 209, 603 7th Ave. SW, Calgary Alberta,
Character of Well (Completed as Oil, Gas or Dry Hole) Canada

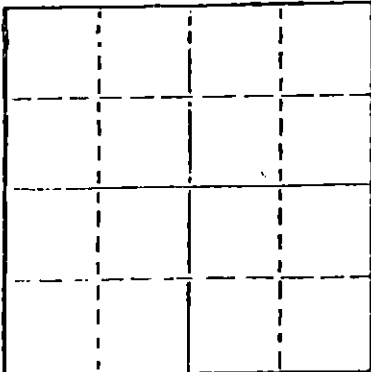

Locate well correctly on above
Section Plat

Dry Hole
Date Well completed 6/23 1981
Application for plugging filed 6/23 1981
Application for plugging approved 6/23 1981
Plugging commenced 6/23 1981
Plugging completed 6/23 1981
Reason for abandonment of well or producing formation _____

Dry Hole
If a producing well is abandoned, date of last production _____
19 _____

Was permission obtained from the Conservation Division or
its agents before plugging was commenced? yes

Name of Conservation Agent who supervised plugging of this well Duane Rankin
Producing formation _____ Depth to top _____ Bottom _____ Total Depth of Well 3325'
Show depth and thickness of all water, oil and gas formations.

OIL, GAS OR WATER RECORDS

CASING RECORD

FORMATION	CONTENT	FROM	TO	SIZE	PUT IN	PULLED OUT
		0	252'	8-5/8"	252'	none

Describe in detail the manner in which the well was plugged, indicating where the mud fluid
was placed and the method or methods used in introducing it into the hold. If cement or other
plugs were used, state the character of same and depth placed, from _____ feet to
_____ feet for each plug set.

Plugged w/ 105 sks. com., 2% gel, 3% c.c.:
50 sks @ 450'; 30 sks @ 250'; 10 sks
& solid bridge @ 40', 10 sks in rathole;
5 sks in water well; plug down 10 PM,
6/23/81, By Hosco.

(If additional description is necessary, use BACK of this sheet)

Name of Plugging Contractor Allen Drilling Company

STATE OF KANSAS COUNTY OF BARTON, ss.
Gary Christopher (employee of owner) or (~~owner or operator~~)
of the above-described well, being first duly sworn on oath, says: That I have knowledge of
the facts, statements, and matters herein contained and the log of the above-described well
as filed and that the same are true and correct. So help me God.

(Signature) Gary Christopher
AP.O. Box 1389, Great Bend, KS 67530
(Address)

SUBSCRIBED AND SWORN TO before me this 30th day of June, 19 81

My commission expires _____



Ruth Brack
Notary Public.

RECEIVED
STATE CORPORATION COMMISSION

JUL - 9 1981

CONSERVATION DIVISION
Wichita, Kansas

7-9-81

DRILLER'S WELL LOG

DATE COMMENCED: 06/18/81
DATE COMPLETED: 06/23/81

Tiverton Petroleum Inc.
BRINING No. 1
150' W N/2 N/2 SW/4
Sec. 1, Twp. 20S, Rge. 11W,
Barton County, KS

ELEVATION: 1760' G.L.
1765' K.B.

2862 - 2892' Shale
2892 - 2982' Shale
2982 - 3012' Lime, shale
3012 - 3272' Lime
3272 - 3325' Dolomite
3325' RTD

FORMATION DATA:
Heebner 2862'
Douglas 2892'
Brown Lime 2982'
Lansing 3012'
Arbuckle 3272'
RTD 3325'

SURFACE DATA:

Ran 6 jts. 20# new 8-5/8" casing; tally: 245.35'; Set @ 252' W/ 190 sks 60/40 poz., 2% gel, 3% c.c., cement. circulated; plug down 2:30 AM, 6/19/81, By Howco.

PLUGGING DATA:

Plugged w/105 sks com. & 2% gel, 3% c.c.: 50 sks @ 450'; 30 sks @ 250'; 10 sks & solid bridge @ 40'; 10 sks in rat hole, 5 sks in water well; plug down 10 PM, 6/23/81, By Howco.

A F F I D A V I T

RECEIVED
STATE CORPORATION COMMISSION

STATE OF KANSAS)
COUNTY OF BARTON) ss.

JUN - 9 1981

CONSERVATION DIVISION
Wichita, Kansas

Gary Christopher, of lawful age, does swear and state that the facts and statements herein contained are true and correct to the best of his knowledge.

Gary Christopher

Subscribed and Sworn to before me this 30th day of June, 1981.



Ruth Brack
_____ Notary Public