


STATE OF KANSAS
STATE CORPORATION COMMISSION

Form CP-4

Give All Information Completely
Make Required Affidavit
Mail or Deliver Report to:
Conservation Division
State Corporation Commission
212 No. Market
Wichita, Kansas 67202

WELL PLUGGING RECORD

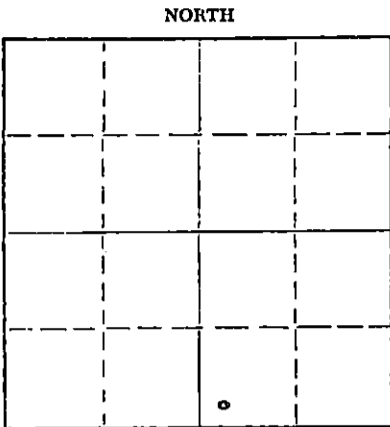

Locate well correctly on above
Section Plat

Rice County. Sec. 11 Twp. 20 Rge. (E) 10 (W)
Location as "NE/CNW&SW&" or footage from lines SW SW SE
Lease Owner Ben C. W. Hyde, Jr.
Lease Name Macemore Well No. 4
Office Address Box 8316, Prairie Village, Kansas 66208
Character of Well (completed as Oil, Gas or Dry Hole) oil
Date well completed 19__
Application for plugging filed October 1 19 71
Application for plugging approved 19__
Plugging commenced November 20 19 71
Plugging completed November 27 19 71
Reason for abandonment of well or producing formation depleted

If a producing well is abandoned, date of last production 19__
Was permission obtained from the Conservation Division or its agents before plugging was commenced? YES

Name of Conservation Agent who supervised plugging of this well Gilbert Toman
Producing formation _____ Depth to top _____ Bottom _____ Total Depth of Well 3330 Feet
Show depth and thickness of all water, oil and gas formations.

OIL, GAS OR WATER RECORDS

CASING RECORD

FORMATION	CONTENT	FROM	TO	SIZE	PUT IN	PULLED OUT
		0	209'	8 5/8"	209'	none
		0	3328'	4 1/2"	3328'	2010.64

Describe in detail the manner in which the well was plugged, indicating where the mud fluid was placed and the method or methods used in introducing it into the hole. If cement or other plugs were used, state the character of same and depth placed, from _____ feet to _____ feet for each plug set.

Sanded back to 3300' and dumped 1/2 sacks of cement.

Squeezed well with 20 sacks of gel, 3 sacks of bulls and 75 sacks of cement.

RECEIVED
STATE CORPORATION COMMISSION
DEC 3 1971
CONSERVATION DIVISION
Wichita, Kansas

(If additional description is necessary, use BACK of this sheet)
Name of Plugging Contractor PIPE PULLERS, INC.
Address Box 486, Ellinwood, Kansas 67526

STATE OF KANSAS, COUNTY OF BARTON, ss.
Evelyn Roth (employee of owner) or (owner or operator) of the above-described well, being first duly sworn on oath, says: That I have knowledge of the facts, statements, and matters herein contained and the log of the above-described well as filed and that the same are true and correct. So help me God.

(Signature) Evelyn Roth
Ellinwood, Kansas (Address)

SUBSCRIBED AND SWORN to before me this 1 day of December, 19 71

My commission expires Feb. 10, 1975

Serge A. Meyer (Notary Public)

WELL LOG

Hyde's Macemore #4
 SW SW SE Section 11-20-10
 Rice County, Kansas

Figures indicate bottom of formation:

Elevation: 1794' KB

0	to	10	cellar
		100	sand shale
		140	shale
		207	hard sand rough
		280	shale
		1285	shale & shells
		1470	shale & lime
		1920	lime & shale
		2535	shale & shells
		3325	lime & shale
		3330	Rotary Total Depth

PIPE RECORD:
 8 5/8" set at 209' with
 175 sacks of cement.
 4 1/2" set at 3328' with
 125' sacks of cement.

ROTARY COMECCED: 10-30-62
 ROTARY COMPLETED: 10-6-62

GEOLOGICAL TOPS:
 Keebner 2866'
 Brown Lime 3000'
 Lansing 3022'
 Arbuckle 3327'
 Rotary Total Depth 3330'

RECEIVED
 STATE CORPORATION COMMISSION
 OCT 4 1971
 CONSERVATION DIVISION
 Wichita, Kansas

STATE OF KANSAS)
) ss
 COUNTY OF BARTON)

I, Richard Hogg, Drilling Superintendent for the above-described well, being first duly sworn on oath, declare: That I have knowledge of the facts, statements and matter herein contained pertaining to the log of the above-described well, as filed, and that the same are true and correct.

R.H. Hogg
 Richard Hogg

Subscribed and sworn to before me on this 9th day of November, 1962.

George A. Meyer
 George A. Meyer, Notary Public

My commission expires February 10, 1963.