


STATE OF KANSAS
STATE CORPORATION COMMISSION

Form CP-4

Give All Information Completely
Make Required Affidavit
Mail or Deliver Report to:
Conservation Division
State Corporation Commission
212 No. Market
Wichita, Kansas 67202

WELL PLUGGING RECORD

NORTH

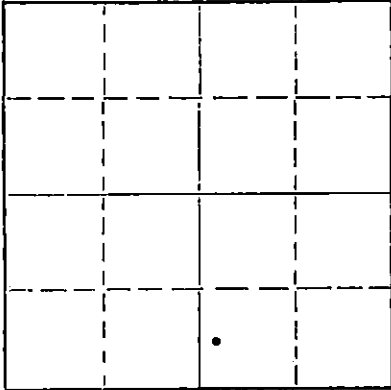

Locate well correctly on above
Section Plat

Rice County. Sec. 11 Twp. 20 Rge. (E) 10 (W)
Location as "NE/CNWxSWx" or footage from lines C W/2 SW SE
Lease Owner Ben C. W. Hyde, Jr.
Lease Name Macemore Well No. 2
Office Address Box 8316, Prairie Village, Kansas 66208
Character of Well (completed as Oil, Gas or Dry Hole) oil
Date well completed 19__
Application for plugging filed October 1 1971
Application for plugging approved 19__
Plugging commenced November 13 1971
Plugging completed November 27 1971
Reason for abandonment of well or producing formation depleted

If a producing well is abandoned, date of last production 19__
Was permission obtained from the Conservation Division or its agents before plugging was commenced? Yes

Name of Conservation Agent who supervised plugging of this well Gilbert Toman
Producing formation _____ Depth to top _____ Bottom _____ Total Depth of Well 3355 Feet
Show depth and thickness of all water, oil and gas formations.

OIL, GAS OR WATER RECORDS

CASING RECORD

FORMATION	CONTENT	FROM	TO	SIZE	PUT IN	PULLED OUT
		0	186'	10 3/4"	186'	none
		0	3350'	7"	3350'	1338.69

Describe in detail the manner in which the well was plugged, indicating where the mud fluid was placed and the method or methods used in introducing it into the hole. If cement or other plugs were used, state the character of same and depth placed, from _____ feet to _____ feet for each plug set.

Sanded back to 2300' and dumped 6 sacks of cement.

Pumped in 25 sacks of mud, 4 sacks of hulls and 100 sacks of cement.

RECEIVED
STATE CORPORATION COMMISSION
DEC 3 1971
CONSERVATION DIVISION
Wichita, Kansas

(If additional description is necessary, use BACK of this sheet)
Name of Plugging Contractor PIPE PULLERS, INC.
Address Box 486, Ellinwood, Kansas 67526

STATE OF KANSAS COUNTY OF BARTON, ss.
Evelyn Roth (employee of owner) or (owner or operator) of the above-described

well, being first duly sworn on oath, says: That I have knowledge of the facts, statements, and matters herein contained and the log of the above-described well as filed and that the same are true and correct. So help me God.

(Signature) Evelyn Roth
Ellinwood, Kansas

(Address)

SUBSCRIBED AND SWORN TO before me this 1 day of December, 1971

My commission expires Feb. 10, 1975

George A Meyer
Notary Public.

WELL LOG

BEN C. W. HYDE, JR. - owner - MACEMORE #2
 C W/2 SW SE of Section 11-20-10W
 Rice County, Kansas

ELEVATION: 1798 KB

PIPE RECORD:

10 3/4" set at 186'
 with 125 sacks of cement
 7" set at 3350'
 with 125 sacks of cement

Rotary Commenced: 12-27-60
 Rotary completed: 1- 9-61

Figures indicate bottom of formation:

0 to 10 cellar
 140 shale and shells
 150 Iron
 390 shale and shells
 440 red bed
 1315 shale and shells
 2100 lime and shale
 2580 shale and shells
 3355 Lime and shale
 3355 Rotary Total Depth

GEOLOGICAL TOPS:

Heebner	2874
Brown Lime	3004
Lansing	3026
Conglom. Sand	3015
Arbuckle	3350
R. T. D.	3355

RECEIVED
 STATE CORPORATION COMMISSION
 OCT 4 1971
 CONSERVATION DIVISION
 Wichita, Kansas

STATE OF KANSAS)
 COUNTY OF BARTON) SS

I, M. M. SHROPSHIRE, DRILLING SUPERINTENDENT, of the above-described well, being first duly sworn on oath, declare: That I have knowledge of the facts, statements and matters herein contained pertaining to the log of the above-described well, as filed, and that the same are true and correct.

M. M. Shropshire

Subscribed and Sworn to before me this 28 day of February, 1961.

George A. Meyer
 George A. Meyer, Notary Public

My commission expires February 10, 1963.