


STATE OF KANSAS
STATE CORPORATION COMMISSION

Form CP-4

WELL PLUGGING RECORD

Give All Information Completely
Make Required Affidavit
Mail or Deliver Report to:
Conservation Division
State Corporation Commission
212 No. Market
Wichita, Kansas

NORTH

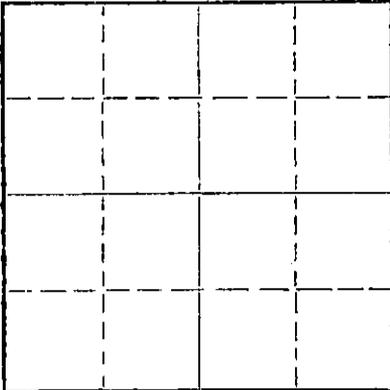

Locate well correctly on above
Section Plat

RICE

County. Sec. ⁴10 Twp. 20 S Rge. 10 W (E) (W)

Location as "NE/CNW%SW%" or footage from lines SW NW SW

Lease Owner Dunbar Drilling inc.

Lease Name Panning Well No. 3

Office Address 5252 North Broadway, Wichita, Kns 67219

Character of Well (completed as Oil, Gas or Dry Hole) Oil

Date well completed September 6, 1969

Application for plugging filed February 21, 1975

Application for plugging approved February 21, 1975

Plugging commenced February 21, 1975

Plugging completed March 3, 1975

Reason for abandonment of well or producing formation Depleted

If a producing well is abandoned, date of last production 19

Was permission obtained from the Conservation Division or its agents before plugging was commenced? yes

Name of Conservation Agent who supervised plugging of this well Gilbert Toman

Producing formation Depth to top Bottom Total Depth of Well 3354 Feet

Show depth and thickness of all water, oil and gas formations.

OIL, GAS OR WATER RECORDS

CASING RECORD

FORMATION	CONTENT	FROM	TO	SIZE	PUT IN	PULLED OUT
				8-5/8"	224	None
				5-1/2"	3349 1/2	2154'

Describe in detail the manner in which the well was plugged, indicating where the mud fluid was placed and the method or methods used in introducing it into the hole. If cement or other plugs were used, state the character of same and depth placed, from feet to feet for each plug set.

SHOT WELL @ 2731-2619- SPOT OIL WORK PIPE

SHOT WELL @ 2411-2232-2148 PIPE LOOSE PULL 2154 FEET OF 5 1/2" CASING

PLUG HOLE WITH 85 SAX CEMENT 20 SAX GET AND 5 SAX HULLS.

RECEIVED

STATE CORPORATION COMMISSION

MAR 19 1975

CONSERVATION DIVISION

Wichita, Kansas

(If additional description is necessary, use BACK of this sheet)

Name of Plugging Contractor DUNBAR DRILLING INC.

Address 5252 North Broadway Wichita, Kansas 67219

STATE OF Kansas, COUNTY OF Sedgwick, ss.

W. P. Simmons (employee of owner) or (owner or operator) of the above-described

well, being first duly sworn on oath, says: That I have knowledge of the facts, statements, and matters herein contained and the log of the above-described well as filed and that the same are true and correct. So help me God.

(Signature) W. P. Simmons

(Address)

sworn to before me this 17th day of March, 19 75

Frances J. Simmons

Frances J. Simmons

Notary Public.

November 19, 1977



DRILLERS' WELL LOG

DATE COMMENCED: August 30, 1969
 DATE COMPLETED: September 6, 1969

Icer Addis
 PANNING #3
 SW/4 NW/4 SW/4
 Sec. 18-T20s-R10w 4.20s.10w
 Russell County, Kansas

ELEVATION: 1809 K.B.

0	-	216'	Sand & Clay
216	-	488'	Red Bed
488	-	508'	Anhydrite
508	-	1300'	Shale & Shells
1300	-	1700'	Shale & Lime
1700	-	2000'	Lime & Shale
2000	-	2410'	Shale
2410	-	2655'	Shale & Lime
2655	-	2914'	Lime
2914	-	2918'	Shale
2918	-	2937'	Lime & Shale
2937	-	2948'	Lime
2948	-	3037'	Shale
3037	-	3067'	Brown lime
3067	-	3317'	Lime
3317	-	3346'	Conglomerate
3346	-	3354'	Dolomite

FORMATION TOPS

Anhydrite	488
Topeka	2647
Heebner	2914
Toronto	2937
Douglas	2948
Brown Lime	3037
Kansas City	3067
Base K.C.	3917
Arbuckle	3346
RTD	3354

SURFACE PIPE: Set new 20#
 8-5/8" pipe at 224' with
 175 sacks cement

PRODUCTION STRING: Set 14#
 Used 5 1/2" casing at 3349 1/2'
 with 100 sacks salt sat. Pozmix.

A F F I D A V I T

STATE OF KANSAS
 COUNTY OF BARTON) ss.

Larry Curtis, of lawful age, does swear and state that the facts and statements herein contained are true and correct to the best of his knowledge.

Larry Curtis
 Larry Curtis

Subscribed and sworn to before me this 11 day of September, 1969.

My Comm. Expires:
April 11, 1970

Wesley M. Hague
 Notary Public

RECEIVED
 STATE CORPORATION COMMISSION
 FEB 24 1975
 CONSERVATION DIVISION
 Wichita, Kansas

RECORDED
 INDEXED
 SEP 11 1969
 BARTON COUNTY, KANSAS