

STATE OF KANSAS
STATE CORPORATION COMMISSION


WELL PLUGGING RECORD

Give All Information Completely
Make Required Affidavit
Mail or Deliver Report to:
Conservation Division
State Corporation Commission
800 Bitting Building
Wichita, Kansas

OR
FORMATION PLUGGING RECORD

Strike out upper line
when reporting plug-
ging of formations.

Rice County. Sec. 10 Twp. 20 Rge. (E) 10 (W)
Location as "NE 1/4 NW 1/4 SW 1/4" or footage from lines. NW SE SW
Lease Owner Westgate-Greenland Oil Company
Lease Name Burchart Well No. 1
Office Address 1022 Union National Bank Building, Wichita 2, Kansas
Character of Well (completed as Oil, Gas or Dry Hole) dry hole
Date well completed January 24, 1948 19
Application for plugging filed May 10, 1948 19
Application for plugging approved May 10, 1948 19
Plugging commenced May 11, 1948 19
Plugging completed May 19, 1948 19
Reason for abandonment of well or producing formation dry hole
If a producing well is abandoned, date of last production 19
Was permission obtained from the Conservation Division or its agents before plugging was com-
menced?

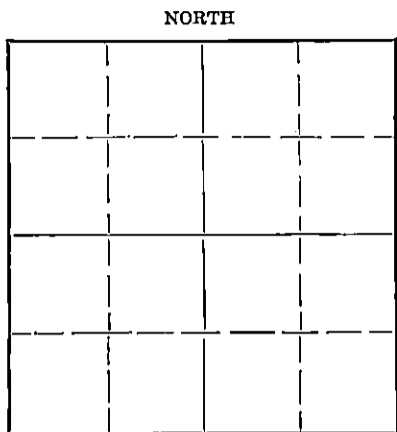

Locate well correctly on above
Section Plat

Name of Conservation Agent who supervised plugging of this well G. E. Bitler, Great Bend, Kansas
Producing formation Depth to top Bottom Total Depth of Well 3460 Feet
Show depth and thickness of all water, oil and gas formations.

OIL, GAS OR WATER RECORDS

CASING RECORD

| Formation | Content | From | To | Size | Put In | Pulled Out |
|-----------|---------|------|------|--------|--------|------------|
| Surface | | 0 | 182' | 8 5/8" | 182 | none |
| | | | | 5 1/2" | 3407 | 1489'4" |
| | | | | | | |
| | | | | | | |
| | | | | | | |
| | | | | | | |
| | | | | | | |
| | | | | | | |
| | | | | | | |
| | | | | | | |

Describe in detail the manner in which the well was plugged, indicating where the mud fluid was placed and the method or methods used in introducing it into the hole. If cement or other plugs were used, state the character of same and depth placed, from feet to feet for each plug set.

Filled with heavy mud to 3090' and dumped 5 sacks cement.
Filled with heavy mud to 182' and dumped 15 sacks cement to 150'.
Filled with heavy mud to 25' and dumped 10 sacks cement to cellar base.

MAY 24 1948

(If additional description is necessary, use BACK of this sheet)

Correspondence regarding this well should be addressed to G. E. Bitler, 1022 Union National Bank Building
Address c/o Westgate-Greenland Oil Company

STATE OF Kansas, COUNTY OF Sedgwick, ss.
G. E. Bitler (employee of owner) of the above-described well,
being first duly sworn on oath, says: That I have knowledge of the facts, statements, and matters herein contained and the log of the above-described well as filed and that the same are true and correct. So help me God.


(Signature) G. E. Bitler

c/o Westgate-Greenland Oil Company
1022 Union National Bank Building, Wichita 2, Ks

SUBSCRIBED AND SWORN to before me this 24th day of May, 1948

Esther Russell
Notary Public

My commission expires May 25, 1949

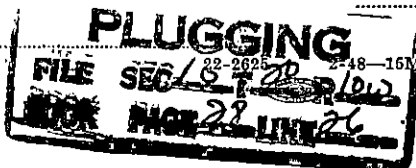

COMPANY : Westgate-Greenland Oil Company
 CONTRACTOR: Mallard Drilling Company
 FARM : Burchard #1
 LOCATION : NW SE SW of Sect. 10-20S-10W, Rice County, Kansas
 COMMENCED : January 14, 1948
 COMPLETED : January 24, 1948

| | | | |
|------|----|------|-----------------------|
| 0 | to | 155 | Surface sand |
| 155 | to | 220 | Shale and shells |
| 220 | to | 480 | Red bed |
| 480 | to | 665 | Shale and shells |
| 665 | to | 1165 | Shale and shells |
| 1165 | to | 1475 | Shale and lime |
| 1475 | to | 1945 | Lime and shale |
| 1945 | to | 2205 | Broken lime and shale |
| 2205 | to | 2945 | Lime and shale |
| 2945 | to | 3069 | Shale |
| 3069 | to | 3075 | Lime |
| 3075 | to | 3089 | Shale |
| 3089 | to | 3220 | Lime |
| 3220 | to | 3265 | Lime and shale |
| 3265 | to | 3410 | Lime |
| 3410 | to | 3428 | Shale and sand |
| 3428 | to | 3460 | Lime |
| | | 3460 | T. D. Rotary |

Set 182 feet of 8 5/8" surface pipe. Cemented with 110 sacks cement

Set 3407 feet of 5 1/2" casing. Cemented with 100 sacks cement

Perforations:

14 shots 3352 to 3365'
 11 shots 3334 to 3346'

Set Lane Wells plug @ 3290'

13 shots 3272 to 3286'

Set Lane Wells plug @ 3205'

36 shots 3179 to 3188'
 12 shots 3170 to 3174'
 22 shots 3161 to 3170'
 Set Lane Wells plug @ 3157'
 24 shots 3145 to 3150'
 18 shots 3135 to 3141'
 Set Lane Wells plug @ 3127'
 11 shots 3120 to 3124'
 9 shots 3109 to 3112'
 12 shots 3099 to 3104'


Present T.D. of Lane Wells plug @ 3127'.

CERTIFICATE

I, G. E. Bitler, do hereby certify that the above and foregoing is a true and correct copy of the log of the Burchard #1, NW SE SW of Sec 10-20-10W, Rice County, Kansas, as reflected by files of the Westgate-Greenland Oil Company

Subscribed and sworn to before me a Notary Public, within and for Sedgwick County, Kansas, this 24th day of May, 1948.

My commission expires May 12, 1949

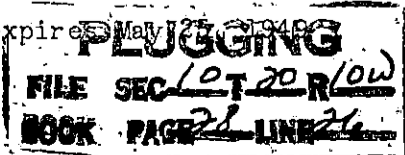

Notary Public