


WELL PLUGGING RECORD

STATE OF KANSAS
 STATE CORPORATION COMMISSION
 Information Completely
 Required Affidavit
 Deliver Report to:
 Conservation Division
 State Corporation Commission
 1 No. Broadway
 Wichita, Kansas

Rice County, Sec. 10 Twp. 20S Rge. 10W (E) (W)
 Location as "NE/CNW%SW%" or footage from lines 990 FWL 330 FNL
 Lease Owner Phillips Petroleum Company
 Lease Name Taylor-D Well No. 1
 Office Address Box 287, Gt. Bend, Kan
 Character of Well (completed as Oil, Gas or Dry Hole) oil
 Date well completed March 56 19
 Application for plugging filed 11-30-67 19
 Application for plugging approved 12-1-67 19
 Plugging commenced 12-5-67 19
 Plugging completed 12-7-67 19
 Reason for abandonment of well or producing formation uneconomical
 If a producing well is abandoned, date of last production 11-27-67 19
 Was permission obtained from the Conservation Division or its agents before plugging was commenced? yes

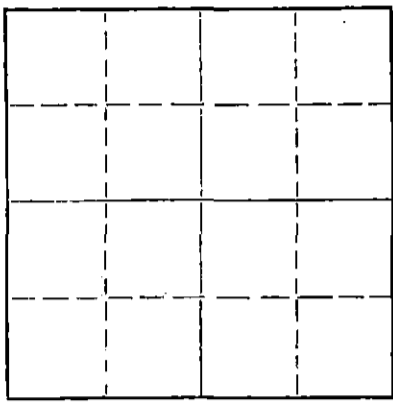

Locate well correctly on above Section Plat

Name of Conservation Agent who supervised plugging of this well Gilbert Toman
 Producing formation _____ Depth to top _____ Bottom _____ Total Depth of Well 3397 Feet
 Show depth and thickness of all water, oil and gas formations.

OIL, GAS OR WATER RECORDS

CASING RECORD

FORMATION	CONTENT	FROM	TO	SIZE	PUT IN	PULLED OUT
				9-5/8	326	none
				7"	3395	2487

Describe in detail the manner in which the well was plugged, indicating where the mud fluid was placed and the method or methods used in introducing it into the hole. If cement or other plugs were used, state the character of same and depth placed, from _____ feet to _____ feet for each plug set.

PB 3397 to 3380 with sand; 3380 to 3308 with 7 sx cement.
 Shot at 2588 and 2492. Started pulling casing. Redcovered 2487' of 7" OD 20# J-55 SS casing, set 10' rock bridge 300' to 290'; 25 sx cement 290 to 222'. Mudded hole to 30', 10 sx cement 30' to surface. Well P&A 4 p.m. 12-7-67.

RECEIVED
 STATE CORPORATION COMMISSION
 DEC 12 1967
 CONSERVATION DIVISION
 Wichita, Kansas

(If additional description is necessary, use BACK of this sheet)

Name of Plugging Contractor Knight Casing Pulling Co.
 Address Chase, Kan

STATE OF Kan COUNTY OF Barton, ss.
 AT Slagle Dist. Supt. (employee of owner) or (owner or operator) of the above-described well, being first duly sworn on oath, says: That I have knowledge of the facts, statements, and matters herein contained and the log of the above-described well as filed and that the same are true and correct. So help me God.

(Signature) AT Slagle
 Box 287, Gt. Bend, Kan
 (Address)

SUBSCRIBED AND SWORN to before me this 8th day of December 1967, 19

Luss Lee Parks
 Notary Public.

My commission expires 10-27-69



15.159.04286.0000

EXPLORATION RECORD

1 - Wille, Prod.
 1 - Division
 1 - District
 1 - Geological Dept. - Evlle.
 1 - Geological Dept. - District

Lease Taylor NDWell 1

Formation Name	Top	Base	Remarks
Sand, shale and shells	0	339	
Sand and shale	339	476	
Anhydrite	476	530	
Shale and shells	530	1220	
Shale, shells and lime	1220	1472	
Lime and shale	1472	1629	
Lime	1629	1892	
Lime and shale	1892	1992	
Shale and shells	1992	2227	
Lime and shale	2227	2550	
Lime	2550	2892	
Lime and shale	2892	3062	
Lime	3062	3355	
Sand and lime	3355	3368	
Lime	3368	*3397	
<u>FORMATION TOPS: (Sample)</u>			
Tarkio	2322		
Willard Sandstone	2350		
Elmont-Reading	2389		
Heebner	2916		
Toronto	2938		
Douglas	2948		
Brown Limestone	3040		
Lansing-Kansas City	3058		
Drum	3207		
Base-Kansas City	3327		
Marston	3333		
Conglomerate Sandstone	3361		
Artuckle	3394		
Rotary Total Depth	3397		
Cable Tool TD	PB 3377		
			*Not penetrated at 3397' TD

RECEIVED
 STATE CORPORATION COMMISSION
 DEC 12 1967
 OIL FIELD DIVISION
 Kansas