


Give All Information Completely  
Make Required Affidavit  
Mail or Deliver Report to:  
Conservation Division  
State Corporation Commission  
212 No. Market  
Wichita, Kansas

WELL PLUGGING RECORD

NORTH

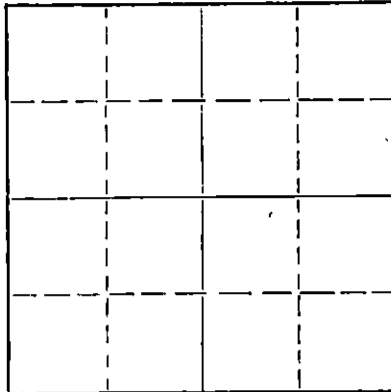

Locate well correctly on above  
Section Plat

RICE County. Sec. 13 Twp. 20S Rge. 10W (E) (W)  
Location as "NE/CNW/SW" or footage from lines SW SW SW  
Lease Owner SANTA-FE PIPE & SUPPLY, INC.  
Lease Name EATINGER Well No. 1  
Office Address P.O. BOX 562, GREAT BEND, KANSAS  
Character of Well (completed as Oil, Gas or Dry Hole) OIL  
Date well completed JUNE 20 19 63  
Application for plugging filed FEBRUARY 15 19 67  
Application for plugging approved FEBRUARY 16 19 67  
Plugging commenced FEBRUARY 27 19 67  
Plugging completed MARCH 1 19 67  
Reason for abandonment of well or producing formation DEPLETED

If a producing well is abandoned, date of last production 19  
Was permission obtained from the Conservation Division or its agents before plugging was commenced? YES

Name of Conservation Agent who supervised plugging of this well MR. GILBERT TOMAN  
Producing formation \_\_\_\_\_ Depth to top \_\_\_\_\_ Bottom \_\_\_\_\_ Total Depth of Well 3378 Feet  
Show depth and thickness of all water, oil and gas formations.

OIL, GAS OR WATER RECORDS

CASING RECORD

FORMATION	CONTENT	FROM	TO	SIZE	PUT IN	PULLED OUT
				8 5/8"	180	NONE
				5 1/2"	3375	2404

Describe in detail the manner in which the well was plugged, indicating where the mud fluid was placed and the method or methods used in introducing it into the hole. If cement or other plugs were used, state the character of same and depth placed, from \_\_\_\_\_ feet to \_\_\_\_\_ feet for each plug set.

3378 - 3363 - PLUG  
 3363 - 3133 - 2" TUBING IN HOLE  
 3133 - 3100 - SAND  
 3100 - 3060 - 5 SACKS CEMENT  
 3060 - 180 - MUD  
 180 - 170 - ROCK BRIDGE  
 170 - 110 - 20 SACKS CEMENT  
 110 - 40 - MUD  
 40 - 30 - ROCK BRIDGE  
 30 - BASE - 10 SACKS CEMENT

RECEIVED  
STATE CORPORATION COMMISSION  
MAR 27 1967  
CONSERVATION DIVISION  
WICHITA, KANSAS

(If additional description is necessary, use BACK of this sheet)  
Name of Plugging Contractor SANTA-FE PIPE & SUPPLY, INC.  
Address P.O. BOX 562, GREAT BEND, KANSAS

STATE OF KANSAS, COUNTY OF BARTON, ss.  
T.L. NUTT (employee of owner) or (owner or operator) of the above-described

well, being first duly sworn on oath, says: That I have knowledge of the facts, statements, and matters herein contained and the log of the above-described well as filed and that the same are true and correct. So help me God.

(Signature) [Signature]  
P.O. BOX 562, GREAT BEND, KANSAS  
(Address)

SUBSCRIBED AND SWORN TO before me this 24TH day of MARCH, 1967

My commission expires JULY 31, 1970  
Mary M. Guenier Notary Public.

STENCILED

NOV 2 1963

15-159-02746-0000

ORIGINAL

Muir-Thompson, Inc.  
#1 EATINGER  
SW SW SW Section 13-20S-10W  
Rice County, Kansas

J. A. 8378  
Geo 140 Sept  
711

Contractor:  
Bea Drilling Co., Inc.  
Box 247, Ellinwood, Kan.

Staked: 6/6/63  
Started: 6/11/63  
Set surface: 6/11/63  
Completed: 6/20/63

Elevation: 1800' DF 1803 KB

Zero: 8:00 ft above casing  
spider.

Casing Record:

9 jts, 183.52 ft of 8 5/8" 28# casing, cemented w/140 sax 12 hr cement by Globe Cementing. Cement circulated. Plug down: 11:00 PM.

103 jts 14# 8 rd thd J-55 rge 2 casing, cemented w/125 sacks salt saturated cement by Halliburton. Plug down 4:30 PM 6/19/63. Csg. tally: Overall 3395.09'; threads: 25.75; Less thds: 3369.34' Casing seat: 3375' Shoe jt. 33.88'

Drill stem tests:

#1 2279-2314 Open 1 hr. Fair blow increasing to good, throughout. Recovered 70' oil cut mud, 180' of gas above fluid. IFP 32#, FFP 50#, FSIP 520#

#2 3035-3120 Open 1 hr. Weak blow throughout test. Recovered 55' of oil specked mud. IFP 80#, FFP 80#, FSIP 96#.

#3 3308-3378 Open 1 hr. Strong blow throughout test. Recovered 600' V.H. O. & G.C. Mud. 780' froggy oil. IFP 90#, FFP 540#, 20 min FSIP 1000#.

Drillers Log

(All measurements to bottom of formation.)

Surface sand, sand, shale	183
Shale	205
Red bed & shale	460
Anhydrite	490
Shale & shells	1225
Shale & lime	1350
Shale & lime	1606
Lime	1875
Shale & lime	2290
Lime & <del>sax</del> sand	2314
Shale & lime	2620
Lime & shale	2825
Lime	2855
Lime & shale	2945
Shale	3035
Lime & shale	3120
Lime	3295
Shale, lime, sand	3370
Shale & lime	3373
Arbuckle	3378
Rotary total depth	3378

*Sample 120, 220*  
*Surf 2309*  
*Hand 3800*  
*Gr. Lim 3004*  
*L. G. C. 3034*  
*arb. 3373*

RECEIVED  
STATE CORPORATION COMMISSION

MAR 27 1967

CONSERVATION DIVISION  
Wichita, Kansas

I hereby certify that the above is a true and correct log of said well as reflected by the daily drilling reports.

*B. F. Krehbiel*  
C. F. Krehbiel, Vice-Pres.  
Bea Drilling Co., Inc. (Contr.)

STATE OF KANSAS, COUNTY OF BARTON, ss

Subscribed and sworn to before me this 24th day of June, 1963.

*[Signature]*  
Notary Public

My commission expires August 1, 1965