

CARD MUST BE TYPED

State of Kansas  
**NOTICE OF INTENTION TO DRILL**  
(see rules on reverse side)

CARD MUST BE SIGNED

Starting Date: May 15, 1985  
month day year

API Number 15- 097-21,141-0000  
120' E

OPERATOR: License # 5004  
Name Vincent Oil Corporation  
Address 125 N. Market, #1110  
City/State/Zip Wichita, Ks. 67202  
Contact Person Ruth Benjamin  
Phone 316-262-3573

of. C... SE 1/4 NW 1/4 Sec. 4 Twp 30 S, Rge 18  
(location)  East  West

3300 Ft North from Southeast Corner of Section  
~~3300~~ 3100 Ft West from Southeast Corner of Section  
(Note: Locate well on Section Plat on reverse side)

CONTRACTOR: License # 5149  
Name Wheatstate Oilfield Services, Inc.  
City/State Pratt, Ks. 67124

Nearest lease or unit boundary line 660 feet.  
County Kiowa  
Lease Name Martin Well# 1

Well Drilled For: Well Class: Type Equipment:  
 Oil  Swd  Infield  Mud Rotary  
 Gas  Inj  Pool Ext.  Air Rotary  
 OWWO  Expl  Wildcat  Cable

Domestic well within 330 feet:  yes  no  
Municipal well within one mile:  yes  no

If OWWO: old well info as follows:

Operator  
Well Name  
Comp Date Old Total Depth  
Projected Total Depth 5100 ft.  
Projected Formation at TD Mississippian  
Expected Producing Formations

Depth to Bottom of fresh water 230 feet  
Lowest usable water formation Kiowa  
Depth to Bottom of usable water 250 feet  
Surface pipe by Alternate: 1  2   
Surface pipe to be set 500 - 8/58" feet  
Conductor pipe if any required n/a feet  
Ground surface elevation applied for feet MSL  
This Authorization Expires 11-8-85  
Approved By 5-8-85

I certify that we will comply with K.S.A. 55-101, et seq., plus eventually plugging hole to K.C.C. specifications

Date May 7, 1985 Signature of Operator or Agent Richard A. Hiebsch Title Vice President


Must be filed with the K.C.C. five (5) days prior to commencing well  
This card void if drilling not started within six (6) months of date received by K.C.C.

RECEIVED  
STATE CORPORATION COMMISSION

Important procedures to follow:

MAY 08 1985  
5-8-85  
CONSERVATION DIVISION  
Wichita, Kansas

A Regular Section of Land  
1 Mile = 5,280 Ft.

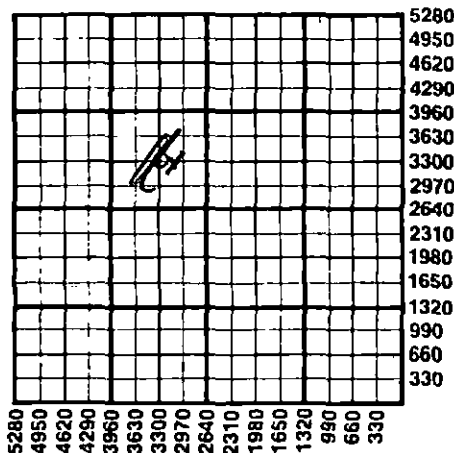

1. Notify District office before setting surface casing.
2. Set surface casing by circulating cement to the top of the casing.
3. File completion forms ACO-1 with K.C.C. within 90 days of well completion, following instructions on ACO-1, side 1, and including copies of wireline logs.
4. Notify District office 48 hours prior to old well workover or re-entry.
5. Prior to plugging, prepare a plugging plan, then obtain agreement from the appropriate district office for an approved plugging plan.
6. Submit plugging report (CP-4) to K.C.C. after plugging is completed.
7. Obtain an approved injection docket number before disposing of salt water.
8. Notify K.C.C. within 10 days when injection commences or terminates.
9. If an alternate 2 completion, cement in the production pipe from below any usable water to surface within 120 days of spud date.

State Corporation Commission of Kansas  
Conservation Division  
200 Colorado Derby Building  
Wichita, Kansas 67202  
(316) 263-3238