


STATE OF KANSAS
STATE CORPORATION COMMISSION
200 Colorado Derby Bldg.
Wichita, Kansas 67202

Form CP-4
Rev. 12-15-80

WELL PLUGGING RECORD

Give All Information Completely
Make Required Affidavit

COUNTY Barton SEC. 7 TWP. 20 RGE. 11 NW
Location as in quarters or footage from lines:
990' from west line & 990' from south line

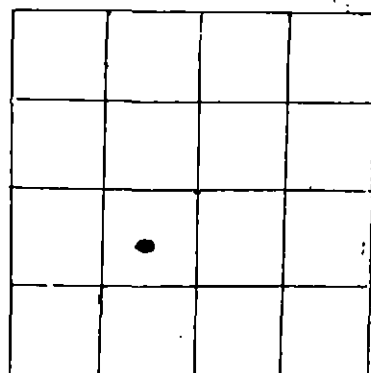

Locate Well
correctly on above
Section Platt.

Lease Owner Thomason Oil Co.
Lease Name Koch A Well No. 2
Office Address 2700 Oak St., Suite A Hays, KS 67601
Character of Well (Completed as Oil, Gas or Dry Hole): Oil
Date Well Completed 12-15-81
Application for plugging filed 8-23-82
Plugging commenced 2:45 P.M.
Plugging completed 3:45 P.M.
Reason for abandonment of well or producing formation Not profitable for oil production

Was permission obtained from the Conservation Division or it's
Agent's before plugging was commenced? Yes

Name of Conservation Agent who supervised plugging of this well Marion Schmidt

Producing formation Arbuckle Depth to top 3318' bottom 3321' T.D. 3327'

Show depth and thickness of all water, oil and gas formations.

OIL, GAS OR WATER RECORDS

Casing Record

Formation	Content	From	To	Size	Put in	Pulled Out
Arbuckle	Dolomite-	3318'	3321'	8 5/8"	328'	None
	Oil & Water			4 1/2"	3323'	1450'

Describe in detail the manner in which the well was plugged, indicating where the mud fluid was placed and the method or methods used in introducing it into the hold. If cement or other plugs were used, state the character of same and depth placed, from _____ feet to _____ feet for each plug set. One Wireline 4 1/2" Cast Iron Plug set @ 3285'.

Ostrom Well Service dumped 5 sxs of cement w/dump bailer on top of 4 1/2" plug; pulled csg. Allied Cementing pumped 4 sxs of hulls, 15 sxs of gel w/1/2 sxs hull, 25 sxs of cement, 5 sxs of gel w/1/2 sxs of hulls down 8 5/8". Then released 8 5/8" plug and pumped down with 140 sxs of 50-50 Pos Mix 4% gel & 3% Calcium Chloride cement.

(If additional description is necessary, use BACK of this sheet)

Name of Plugging Contractor Ostrom Well Service

STATE OF Kansas COUNTY OF Ellis, ss.

Steven Thomason (employee of owner) or (owner or operator) of the above-described well, being first duly sworn on oath, says: That I have knowledge of the facts, statements, and matters herein contained and the log of the above-described well as filed and that the same are true and correct. So help me God.

(Signature) Steven Thomason
2520 Marjorie Drive
Hays, KS (Address) 67601

SUBSCRIBED AND SWORN TO before me this 15 day of November, 19 82

My Commission expires: 5-21-85



ROXIE VON LINTEL
NOTARY PUBLIC
STATE OF KANSAS
MY APPT. EXPIRES

RECEIVED
STATE CORPORATION COMMISSION
Notary Public.

NOV 16 1982

CONSERVATION DIVISION
Wichita, Kansas