


Give All Information Completely
Make Sworn Affidavit
Mail or Deliver Report to:
Conservation Division
State Corporation Commission
800 Bittling Building
Wichita, Kansas

OR
FORMATION PLUGGING RECORD

Strike out upper line
when reporting plugging
off formations.

NORTH

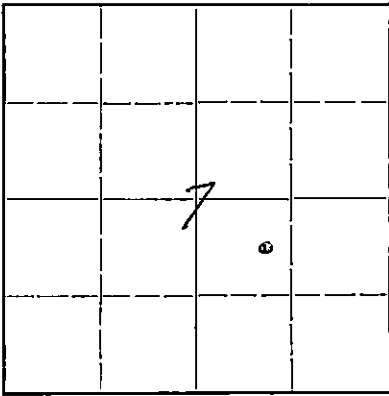

Locate well correctly on above
Section Plat

Barton County. Sec. 7 Twp. 20 Rge. 11 (W)

Location as "NE $\frac{1}{4}$ NW $\frac{1}{4}$ SW $\frac{1}{4}$ " or footage from lines E/2,NW/4 SE/4

Lease Owner PRAIRIE STATE DRILLING COMPANY, et al

Lease Name Frank Petz Well No. 1

Office Address 415 Kaufman Building, Wichita 2, Kansas

Character of Well (completed as Oil, Gas or Dry Hole) Oil Well (Now dry)

Date well completed March 20, 1940 19..

Application for plugging filed March 27, 1947 19..

Application for plugging approved April 3, 1947 19..

Plugging commenced April 8, 19.. 47

Plugging completed April 18, 19.. 47

Reason for abandonment of well or producing formation Ceased producing

If a producing well is abandoned, date of last production September 19.. 45

Was permission obtained from the Conservation Division or its agents before plugging was commenced? Yes

Name of Conservation Agent who supervised plugging of this well Mr. Herb Kerr

Producing formation Arbuckle Depth to top 3320 Bottom 3340 Total Depth of Well 3340 Feet

Show depth and thickness of all water, oil and gas formations.

OIL, GAS OR WATER RECORDS


CASING RECORD

Formation	Content	From	To	Size	Put In	Pulled Out
<u>Surface Casing</u>				<u>10 3/4"</u>	<u>216'</u>	<u>None</u>
				<u>5 1/2"</u>	<u>3320'</u>	<u>2567'</u>

Describe in detail the manner in which the well was plugged, indicating where the mud fluid was placed and the method or methods used in introducing it into the hole. If cement or other plugs were used, state the character of same and depth placed, from.....feet to.....feet for each plug set.

3230 to 3200 ft. Cement 6 Sx
3200 to 200 ft. Mud
200 to 210 ft. Rock bridge
210 to 175 ft. Cement 20 Sx
175 to 20 ft. Mud
20 to Top Cement 10 Sx

Cement dumped in hole with regular cement dump bailer.
Mud was put in hole with slip and shovel.

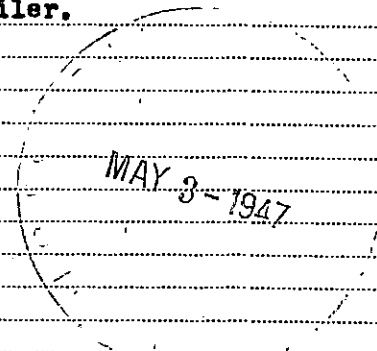

(If additional description is necessary, use BACK of this sheet)

Correspondence regarding this well should be addressed to PRAIRIE STATE DRILLING COMPANY
 Address 415 Kaufman Building, Wichita 2, Kansas

STATE OF Kansas, COUNTY OF Sedgwick, SS.

V. L. REED (employee of owner) or (owner or operator) of the above-described well, being first duly sworn on oath, says: That I have knowledge of the facts, statements, and matters herein contained and the log of the above-described well as filed and that the same are true and correct. So help me God PRAIRIE STATE DRILLING COMPANY

(Signature) V. L. Reed

415 Kaufman Building, Wichita 2, Kansas
(Address)

SUBSCRIBED AND SWORN to before me this 29th day of April, 19.. 47

My commission expires 8-17-49

Agnes Grosvenor
Notary Public.

PLUGGING
FILE SEC. 7 T. 20 R. 11
BOOK PAGE 105 LINE 1

FRANK PETZ WELL NO. 1

Center of E/2 NW/4 SE/4 Sec. 7-20-11W, Barton County, Kansas

Operator: Prairie State Drilling Company (Formerly Simpson & Noble, Inc.);

Alpine Oil & Royalty Company, Inc.

Contractor: Simpson & Noble, Inc.

Rotary and completed with Cable Tools

Acid: 1500 Gal.

Total Depth: 3340'

Commenced: 2-23-40

Completed: 3-20-40


Potential: 2732 Bbls.

LOG

Surface	30
Sand	80
Sand and gumbo	190
Red bed	221
(10 3/4" csg. @ 216)	
Red bed	530
Anhydrite	550
Shale and shells	590
Shale, shells and red bed	835
Shale and shells	1074
Salt and shale	1200
Shale and shells	3360
Lime and shale breaks	1470
Broken lime	2185
Shale and shells	2270
Broken lime	2389
Shale	2512
Broken lime	2812
Lime	2969
Broken lime	3089
Lime (K.C.)	3145
Lime	3303
Lime and shale breaks	3319
Lime (Siliceous)	3323
(5 1/2" csg. @ 3320)	
Lime (T.D.)	3340

SAMPLE TOPS

Elevation	1786
Topeka	2690
Lansing	3089
Arbuckle	3320
Total Depth	3340

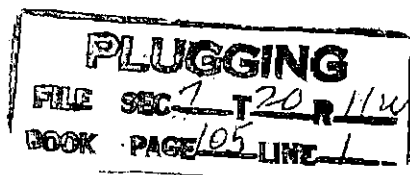

MAR 27 1947