


STATE OF KANSAS  
STATE CORPORATION COMMISSION

Give All Information Completely  
Make Required Affidavit  
Mail or Deliver Report to:  
Conservation Division,  
State Corporation Commission  
211 No. Broadway  
Wichita, Kansas

WELL PLUGGING RECORD

NORTH

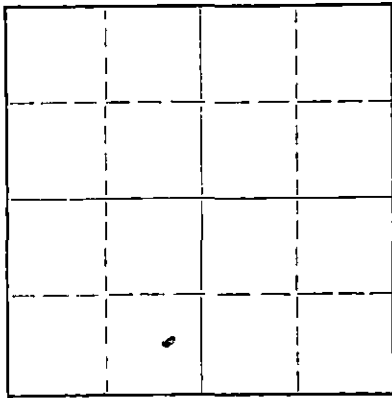

Locate well correctly on above  
Section Plat

Rice County. Sec. 11 Twp. 20 Rge. (E) 10 (W)  
Location as "NE/CNW/SW" or footage from lines Approx. C E/2 SE SW  
Lease Owner Ben C. W. Hyde, Jr.  
Lease Name Kitsy Well No. 2  
Office Address 4722 Broadway, Kansas City 12, Missouri  
Character of Well (completed as Oil, Gas or Dry Hole) oil  
Date well completed \_\_\_\_\_ 19\_\_\_\_  
Application for plugging filed 1-29 19 63  
Application for plugging approved \_\_\_\_\_ 19\_\_\_\_  
Plugging commenced 1-29 19 63  
Plugging completed 2-2 19 63  
Reason for abandonment of well or producing formation depleted

If a producing well is abandoned, date of last production \_\_\_\_\_ 19\_\_\_\_  
Was permission obtained from the Conservation Division or its agents before plugging was commenced? yes

Name of Conservation Agent who supervised plugging of this well Gilbert Toman  
Producing formation \_\_\_\_\_ Depth to top \_\_\_\_\_ Bottom \_\_\_\_\_ Total Depth of Well 3085 Feet  
Show depth and thickness of all water, oil and gas formations.

OIL, GAS OR WATER RECORDS

CASING RECORD

FORMATION	CONTENT	FROM	TO	SIZE	PUT IN	PULLED OUT
		0	190	8 5/8"	190	none
		0	3084	4 1/2"	3084	2352.70

Describe in detail the manner in which the well was plugged, indicating where the mud fluid was placed and the method or methods used in introducing it into the hole. If cement or other plugs were used, state the character of same and depth placed, from \_\_\_\_\_ feet to \_\_\_\_\_ feet for each plug set.

Sand back to 3055', set 10' rock bridge and dumped  
3 sacks of cement. Bailed hole down to 190', set  
10' rock bridge, dumped 20 sacks of cement; filled  
with mud to 40', set 5' rock bridge and dumped 10  
sacks of cement.

RECEIVED  
STATE CORPORATION COMMISSION

FEB 21 1963

CONSERVATION DIVISION  
Wichita, Kansas

(If additional description is necessary, use BACK of this sheet)  
Name of Plugging Contractor Pipe Pullers, Inc.  
Address Box 486, Ellinwood, Kansas

STATE OF Kansas, COUNTY OF Barton, ss.  
Dean Wells (employee of owner) or (~~owner or operator~~) of the above-described well, being first duly sworn on oath, says: That I have knowledge of the facts, statements, and matters herein contained and the log of the above-described well as filed and that the same are true and correct. So help me God.

(Signature) Dean Wells  
Ellinwood, Kansas

(Address)

SUBSCRIBED AND SWORN to before me this 6th day of February, 19 63

W. H. Rader  
Notary Public.

My commission expires July 7, 1964



JAN 30 1963

## WELL LOG

CONSERVATION DIVISION  
Wichita, Kansas

BEN C. W. HYDE, JR., owner, KITSY #2  
Approx. C E/2 SE SW of Sec. 11-20-10W  
Rice County, Kansas

ELEVATION: 1795 KB	0	to	10	cellar
				93 shale and shells
PIPE RECORD:				115 sand
8 5/8" set at 200'				200 shale and shells
with 125 sacks of cement				450 red rock
4 1/2" set at 3085'				975 shale and shells
with 150 sacks of cement				1290 salt
				1390 shale and shells
Rotary Commenced: 2-8-61				2170 lime and shale
Rotary completed: 2-15-61				2505 shale and shells
				2605 shale and sand
GEOLOGICAL TOPS:				2814 Lime and shale
Heebner 2871				3035 Broken lime
Brown Lime 3004				3085 lime and shale
Lansing 3026				3085 Rotary Total Depth
R. T. D. 3085				

I, M. M. SHROPSHIRE, Drilling Superintendent of the above described well, being first duly sworn on oath, declare: That I have knowledge of the facts, statements and matters herein contained pertaining to the log of the above-described well, as filed, and that the same are true and correct.

M. M. Shropshire

Subscribed and sworn to before me this 28 day of February, 1961.

George A. Meyer  
George A. Meyer, Notary Public

My commission expires February 10, 1963.