


WELL PLUGGING RECORD

Give All Information Completely  
Make Return Affidavit  
Mail or Deliver Report to:  
Conservation Division  
State Corporation Commission  
211 No. Broadway  
Wichita, Kansas

NORTH

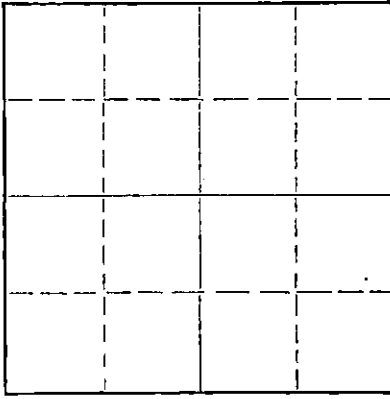

Locate well correctly on above  
Section Plat

Rice County. Sec. 11 Twp. 20 Rge. 10 (X) (W)  
Location as "NE/CNW4SW4" or footage from lines SW SW NW  
Lease Owner Ben C. W. Hyde Jr.  
Lease Name Armstrong Well No. 1  
Office Address 4722 Broadway, Kansas City 12, Mo.  
Character of Well (completed as Oil, Gas or Dry Hole) Dry Hole  
Date well completed 12-6 19 57  
Application for plugging filed 12-6 19 57  
Application for plugging approved 12-6 19 57  
Plugging commenced 12-6 19 57  
Plugging completed 12-6 19 57  
Reason for abandonment of well or producing formation Dry Hole

If a producing well is abandoned, date of last production \_\_\_\_\_ 19\_\_\_\_  
Was permission obtained from the Conservation Division or its agents before plugging was commenced? Yes

Name of Conservation Agent who supervised plugging of this well Harold Hollis & Gilbert Toman  
Producing formation \_\_\_\_\_ Depth to top \_\_\_\_\_ Bottom \_\_\_\_\_ Total Depth of Well 3425 Feet  
Show depth and thickness of all water, oil and gas formations.

OIL, GAS OR WATER RECORDS

CASING RECORD

FORMATION	CONTENT	FROM	TO	SIZE	PUT IN	PULLED OUT
		0	212'	8 5/8"	212'	none

Describe in detail the manner in which the well was plugged, indicating where the mud fluid was placed and the method or methods used in introducing it into the hole. If cement or other plugs were used, state the character of same and depth placed, from \_\_\_\_\_ feet to \_\_\_\_\_ feet for each plug set.

Filled hole with heavy mud to 205'  
Bridged hole at 205'. Ran 20 sacks lone star  
cement 205'-up. Heavy mud to 40'. Set plug  
at 40'. Ran 10 sacks cement 40' to base of  
cellar.

RECEIVED  
STATE CORPORATION COMMISSION  
DEC 13 1957  
12-13-57  
CONSERVATION DIVISION  
Wichita, Kansas

(If additional description is necessary, use BACK of this sheet)

Name of Plugging Contractor Isern Drilling Company  
Address P. O. Box 45 Ellinwood, Kansas

STATE OF Kansas, COUNTY OF Barton, ss.  
M. M. Shropshire (employee of owner) or (owner or operator) of the above-described well, being first duly sworn on oath, says: That I have knowledge of the facts, statements, and matters herein contained and the log of the above-described well as filed and that the same are true and correct. So help me God.

(Signature) M. M. Shropshire  
Box 45 Ellinwood, Kansas (Address)

SUBSCRIBED AND SWORN TO before me this 10 day of December, 19 57

My commission expires February 10, 1959

George A. Meyer Notary Public.

PLUGGING  
FILE SEC 11 T 20 R 10 W  
BOOK PAGE 67 LINE 21

WELL LOG

BEN C. W. HYDE JR., OWNER - ARMSTRONG #1  
 SW SW NW Section 11, Township 20, Range 10  
 Rice County, Kansas

ELEVATION: 1787 KB

Figures to indicate bottom of formation:

PIPE RECORD:

8 5/8" set 212'  
 Cemented with 175 sacks cement.  
 300# Calcium Chloride  
 November 27, 1957

Rotary Commenced 11-27-57  
 " Completed 12-6-57

Top of Anhydrite 455  
 Heebner 2876  
 Brown Lime 3007  
 Lansing 3026  
 Conglomerate 3330  
 Arbuckle 3373

0	to	90	clay & sand
		250	shale & shells
		455	red rock
		485	Anhydrite
		900	shale & shells
		1200	salt
		1900	lime & shale
		2580	shale & shells
		3330	lime & shale
		3341	sand
		3373	sandy lime & shale
		3425	Lime & shale

RECEIVED  
 STATE CORPORATION COMMISSION

DEC 13 1957

CONSERVATION DIVISION  
 Wichita, Kansas

STATE OF KANSAS )  
 COUNTY OF BARTON ) SS

I, M. M. Shropshire, Drilling Superintendent of the above-described well, being first duly sworn on oath, declare: That I have knowledge of the facts, statements and matters herein contained pertaining to the log of the above-described well, as filed, and that the same are true and correct.

M. M. Shropshire

Subscribed and Sworn to before me this 10th day of December, 1957

George A. Meyers  
 Notary Public

My commission expires Feb. 10, 1959.

PLUGGING  
 FILE SEC 11 T 20 R 10W  
 BOOK PAGE 67 LINE 21