


STATE OF KANSAS
STATE CORPORATION COMMISSION

Give All Information Completely
Make Required Affidavit
Mail or Deliver Report to:
Conservation Division
State Corporation Commission
211 No. Broad
Wichita, Kansas

WELL PLUGGING RECORD

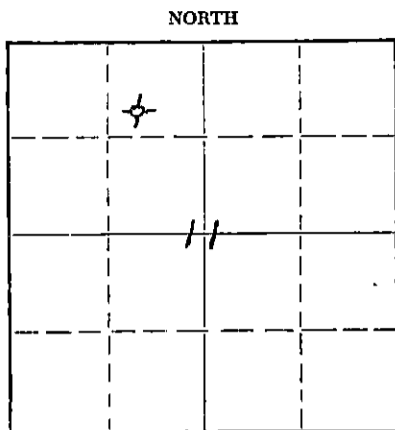

Locate well correctly on above
Section Plat

Rice County. Sec. 11 Twp. 20 Rge. (E) 10 (W)
Location as "NE/CNW/SW" or footage from lines SW NE NW
Lease Owner Donald T. Ingling et al
Lease Name Glaser Well No. 1
Office Address 615 First National Bldg., Wichita, Kansas
Character of Well (completed as Oil, Gas or Dry Hole) Dry Hole
Date well completed April 5 1965
Application for plugging filed June 29 1965
Application for plugging approved June 29 1965
Plugging commenced June 29 1965
Plugging completed July 1 1965
Reason for abandonment of well or producing formation No oil when tested

If a producing well is abandoned, date of last production _____ 19____
Was permission obtained from the Conservation Division or its agents before plugging was commenced? Yes

Name of Conservation Agent who supervised plugging of this well Herman Justus
Producing formation _____ Depth to top _____ Bottom _____ Total Depth of Well 3351 Feet
Show depth and thickness of all water, oil and gas formations.

OIL, GAS OR WATER RECORDS

CASING RECORD

FORMATION	CONTENT	FROM	TO	SIZE	PUT IN	PULLED OUT
				8 5/8"	212	none
				4 1/2"	2411	2047 1/2

Describe in detail the manner in which the well was plugged, indicating where the mud fluid was placed and the method or methods used in introducing it into the hole. If cement or other plugs were used, state the character of same and depth placed, from _____ feet to _____ feet for each plug set.

Filled back in the 4 1/2" with rock and gravel. Dumped 5 sacks of cement. Shot pipe off at 2047.50'. Pulled pipe and mudded hole to 200'. Set rock bridge and dumped 20 sacks of cement. Mudded hole to 40' and dumped 10 sacks of cement.

RECEIVED
STATE CORPORATION COMMISSION

JUL 27 1965

CONSERVATION DIVISION
Wichita, Kansas

(If additional description is necessary, use BACK of this sheet)

Name of Plugging Contractor Bert Self
Address Hutchinson, Kansas

STATE OF KANSAS, COUNTY OF SEDGWICK, ss.
D. T. Ingling (employee of owner) or (owner or operator) of the above-described well, being first duly sworn on oath, says: That I have knowledge of the facts, statements, and matters herein contained and the log of the above-described well as filed and that the same are true and correct. So help me God.

(Signature) D. T. Ingling
615 First Natl Bldg., Wichita, Kansas
(Address)

SUBSCRIBED AND SWORN TO before me this 6th day of July, 1965

My commission expires February 27, 1968 Notary Public.

WELL LOG - GLASER NO. 1

15 159.30036.0000

Donald T. Ingling et al, Lease Owner

Section 11-20-10W

Donald T. Ingling, Contractor

Location: SW NE NW

Commenced: 1-11-65

County: Rice

Completed: 1-20-65

Production:

Total Depth: 3351' (rotary)

Elevation: 1777 RB

Casing: 8 5/8" 212' (125 sacks cement)

4 1/2" 2411' (65 sacks cement)

Figures below indicate bottom formation

150 surface and sand
 212 shale and red rock
 685 red rock and shale
 1265 shale and shells
 1465 lime and shale
 1665 lime
 1770 lime
 1830 lime
 2000 shale and lime
 2200 shale and lime
 2370 shale and lime
 2550 lime and shale
 2690 lime and shale
 2760 lime
 2835 lime
 2847 Hebener - top
 2920 lime
 2988 Brown Lime - top
 3000 shale and lime
 3007 Kansas City-Lansing - top
 3045 lime
 3110 lime
 3171 lime
 3240 lime
 3310 Conglomerate sand - top
 3314 Simpson shale
 3315 Simpson - top
 3336 Simpson sand
 3342 Arbuckle lime - top
 3351 Arbuckle
 3351 Total Depth

RECEIVED
STATE CORPORATION COMMISSION

JUL 27 1965

CONSERVATION DIVISION
Wichita, Kansas

I certify this is a true and correct copy of the above mentioned well.

STATE OF KANSAS)
) ss.
SEDGWICK COUNTY)

Donald T. Ingling

Subscribed and sworn to before me, a Notary Public, in said county and state.

W.E. Beach
Notary Public

My commission expires: Feb. 27, 1968