

STATE OF KANSAS  
STATE CORPORATION COMMISSION

Give All Information Completely  
Make Required Affidavit  
Mail or Deliver Report to:  
Conservation Division  
State Corporation Commission  
211 No. Broadway  
Wichita, Kansas

WELL PLUGGING RECORD

Rice County. Sec. 11 Twp. 20S Rge. (E) 10(W)

Location as "NE/CNWxSWx" or footage from lines. G E/2 E/2 SE

Lease Owner Ben C. W. Hyde, Jr.

Lease Name Macemore Well No. 3

Office Address 4722 Broadway, Kansas City 12, Missouri

Character of Well (completed as Oil, Gas or Dry Hole) oil

Date well completed 19

Application for plugging filed Nov. 1 1962

Application for plugging approved 19


Plugging commenced Nov. 3 1962

Plugging completed Nov. 6 1962

Reason for abandonment of well or producing formation  
No longer profitable

If a producing well is abandoned, date of last production 19

Was permission obtained from the Conservation Division or its agents before plugging was commenced? yes

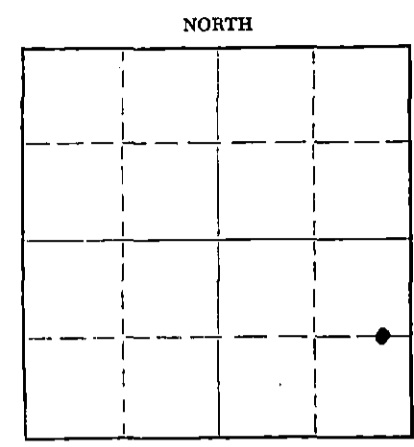

Locate well correctly on above Section Plat

Name of Conservation Agent who supervised plugging of this well Gilbert Toman

Producing formation Lansing Depth to top Bottom Total Depth of Well 3114 Feet

Show depth and thickness of all water, oil and gas formations.

OIL, GAS OR WATER RECORDS

CASING RECORD

FORMATION	CONTENT	FROM	TO	SIZE	PUT IN	PULLED OUT
		0	196	10 3/4	196	none
		0	3114	4 1/2	3114	2527.14

Describe in detail the manner in which the well was plugged, indicating where the mud fluid was placed and the method or methods used in introducing it into the hole. If cement or other plugs were used, state the character of same and depth placed, from feet to feet for each plug set.

Plug back with sand to 3050', dumped 5 sacks cement. Fill hole with mud back to 185', set 10' rock bridge, dump 25 sacks cement. Mud hole back to 30', set rock bridge. Cap with 10 sacks cement.

RECEIVED  
STATE CORPORATION COMMISSION

NOV 9 1962 11-9-62

CONSERVATION DIVISION  
Wichita, Kansas

(If additional description is necessary, use BACK of this sheet)  
Name of Plugging Contractor Pipe Pullers, Inc.  
Address Box 486, Ellinwood, Kansas

STATE OF Kansas, COUNTY OF Barton, ss.  
Dean Wells (employee of owner) or (owner or operator) of the above-described well, being first duly sworn on oath, says: That I have knowledge of the facts, statements, and matters herein contained and the log of the above-described well as filed and that the same are true and correct. So help me God.

(Signature) Dean Wells  
Ellinwood, Kansas  
(Address)

SUBSCRIBED AND SWORN to before me this 8 day of November, 1962

J. J. Rader

My commission expires July 7, 1964

Notary Public.



**RECEIVED**  
STATE CORPORATION COMMISSION

NOV 9 1962

CONSERVATION DIVISION  
Wichita, Kansas

WELL LOG

BEN C. W. HYDE, JR., owner, MACEMORE #3  
SE NE SE of Section 11-20-10W  
Rice County, Kansas

ELEVATION: 1783 KB

PIPE RECORD:

10 3/4" set at 196'  
with 125 sacks of cement  
4 1/2" set at 3114'  
with 100 sacks of cement

Rotary Commenced: 1-10-61  
Rotary Completed: 1-17-61

GEOLOGICAL TOPS:

Heebner	2885
Brown Lime	3028
Lansing	3041
R. T. D.	3115

STATE OF KANSAS )  
COUNTY OF BARTON) SS

I, M. M. SHROPSHIRE, Drilling Superintendent of the Above-described well, being first duly sworn on oath, declare: That I have knowledge of the facts, statements and matters herein contained pertaining to the log of the above-described well, as filed, and that the same are true and correct.

M. M. Shropshire

Subscribed and sworn to before me this 28 day of February, 1961.

George A. Meyer  
George A. Meyer, Notary Public

My commission expires February 10, 1963.

KWJL