

TO:
STATE CORPORATION COMMISSION
CONSERVATION DIVISION
800 Bitting Building
Wichita, Kansas

FILE 40-7

Location CW 1/2 - 3E

Sec. 11 Twp. 19 Rge. 8W

I have today completed supervision of plugging of:

Well No. 1 Lease Ellis

Operator Cities Service Gas Co Address Chase Kans

Field Wildcat County Rice | Twp. 3324

Well Classification: Oil _____ Gas _____ Dry Hole

(Describe briefly the manner in which well was plugged)

Filled with heavy sand from bottom to top between plugs - 15 sec cement at 200 - 8 sec ^{cement} top of surface pipe - welded metal cap over surface pipe

Expense incurred as follows:

Date _____ *Day _____ Mileage _____ 7-6-1942


Date _____ *Day _____ Mileage _____

Date _____ *Day _____ Mileage _____

Hotel, meals, etc. \$ _____

*Show as 1/4, 2/4, 3/4 or 4/4.

[Handwritten signature]
Conservation Agent

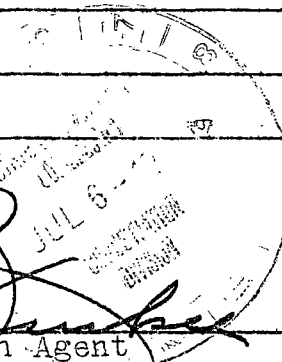

P.O. W.P. Pherson Kans Date 7-3-42

G
FIL: 11 19.8.42
BOOK: 40 7