

STATE OF KANSAS
STATE CORPORATION COMMISSION


WELL PLUGGING RECORD

Give All Information Completely
Make Required Affidavit
Mail or Deliver Report to:
Conservation Division
State Corporation Commission
500 Bitting Building
Wichita, Kansas

OR
FORMATION PLUGGING RECORD

Strike out upper line
when reporting plug-
ging off formations.

NORTH

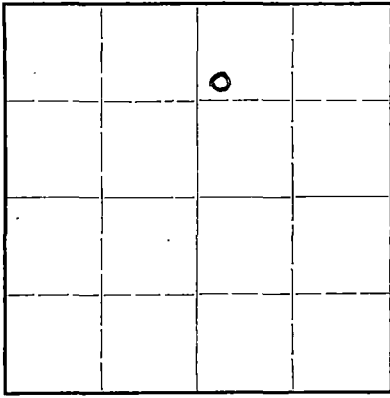

Locate well correctly on above
Section Plat

Rice County, Sec. 20 Twp. 18S Rge. 8W (E) (W)
Location as "NE 1/4 NW 1/4 SW 1/4" or footage from lines SW 1/4 NW 1/4 NE 1/4
Lease Owner. Continental Oil Co.
Lease Name. Adams Well No. 1
Office Address. Ponca City, Oklahoma
Character of Well (completed as Oil, Gas or Dry Hole). Stratigraphic test
Date well completed. Nov. 26, 19 44
Application for plugging filed. Nov. 30, 19 44
Application for plugging approved. Nov. 30, 19 44
Plugging commenced. Nov. 30, 19 44
Plugging completed. Nov. 30, 19 44
Reason for abandonment of well or producing formation.

If a producing well is abandoned, date of last production. 19
Was permission obtained from the Conservation Division or its agents before plugging was com-
menced? Yes

Name of Conservation Agent who supervised plugging of this well. Mr. Durkee
Producing formation. Depth to top. Bottom. Total Depth of Well. Feet
Show depth and thickness of all water, oil and gas formations.

OIL, GAS OR WATER RECORDS


CASING RECORD

Formation	Content	From	To	Size	Put In	Pulled Out
				8 5/8"	221 ft.	none

Describe in detail the manner in which the well was plugged, indicating where the mud fluid was placed and the method or methods used in introducing it into the hold. If cement or other plugs were used, state the character of same and depth placed, from feet to feet for each plug set.

The hole was filled with heavy mud to 220 feet where a wood plug was set and cemented with 20 sacks of cement thru the drill pipe. The hole was then filled to 20 feet where another wood plug was set and cemented to the top of the hole.

PLUGGING
FILE 20 18 8 W
BOOK PAGE 142 3

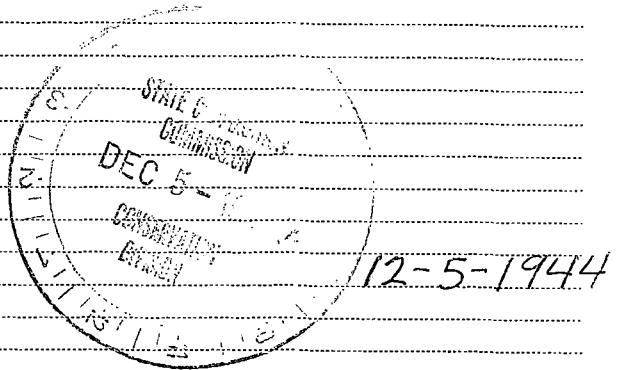

(If additional description is necessary, use BACK of this sheet)

Correspondence regarding this well should be addressed to J. George Klein
Address. Box 183 Great Bend, Kansas

STATE OF Kansas, COUNTY OF Barton, ss.
J. George Klein (employee of owner) or ~~owner~~ of the above-described well,
being first duly sworn on oath, says: That I have knowledge of the facts, statements, and matters herein contained and the log of the above-described well as filed and that the same are true and correct. So help me God.

(Signature) J. George Klein
Great Bend, Kans. (Address)

SUBSCRIBED AND SWORN to before me this 4 day of December, 19 44
Notary Public.

My commission expires. My commission expires Feb. 7, 1946