


STATE OF KANSAS
STATE CORPORATION COMMISSION

Form CP-4

WELL PLUGGING RECORD

Give All Information Completely
Make Required Affidavit
Mail or Deliver Report to:
Conservation Division
State Corporation Commission
212 No. Market
Wichita, Kansas

Rice County, Sec. 9 Twp. 18S Rge. (E) 8 (W)
Location as "NE/CNW%SW%" or footage from lines NW SW NW
Lease Owner J. C. Graves & Nadel & Gussman
Lease Name Dobrinski Well No. 1
Office Address 412 Union Center, Wichita, Kansas
Character of Well (completed as Oil, Gas or Dry Hole) Dry Hole
Date well completed January 20, 19 66
Application for plugging filed January 20, 19 66
Application for plugging approved January 20, 19 66
Plugging commenced January 20, 19 66
Plugging completed January 20, 19 66
Reason for abandonment of well or producing formation

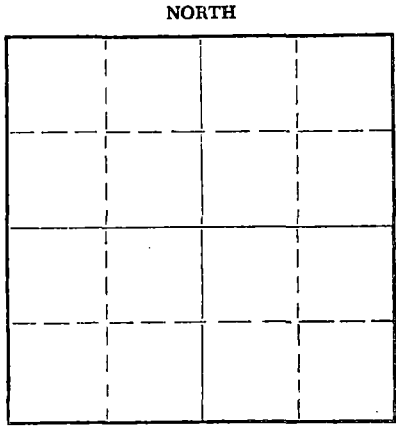

Locate well correctly on above Section Plat

If a producing well is abandoned, date of last production 19
Was permission obtained from the Conservation Division or its agents before plugging was commenced? Yes

Name of Conservation Agent who supervised plugging of this well Harold J. Hollis
Producing formation Depth to top Bottom Total Depth of Well 3517 Feet
Show depth and thickness of all water, oil and gas formations.

OIL, GAS OR WATER RECORDS

CASING RECORD

FORMATION	CONTENT	FROM	TO	SIZE	PUT IN	PULLED OUT
				8-5/8"	219'	None

Describe in detail the manner in which the well was plugged, indicating where the mud fluid was placed and the method or methods used in introducing it into the hole. If cement or other plugs were used, state the character of same and depth placed, from feet to feet for each plug set.

Mudded up with heavy mud to 210 feet. Followed by wooden plug and 1/4 sack hulls. Placed 25 sacks cement onto hulls. Mudded up with heavy mud to 40 feet followed by wooden plug, 1/4 sack hulls and 15 sacks cement to base of well cellar. Plugged rat hole with 2 sacks cement.

RECEIVED
STATE CORPORATION COMMISSION

JAN 25 1966

1-25-1966

CONSERVATION DIVISION
WICHITA, KANSAS

(If additional description is necessary, use BACK of this sheet)
Name of Plugging Contractor Graves Drilling Co., Inc.
Address 412 Union Center, Wichita, Kansas

STATE OF KANSAS, COUNTY OF BUTLER, ss.
John C. Graves (employee of owner) or (owner or operator) of the above-described

well, being first duly sworn on oath, says: That I have knowledge of the facts, statements, and matters herein contained and the log of the above-described well as filed and that the same are true and correct. So help me God.

(Signature) *John C. Graves*
412 Union Center, Wichita, Kansas 67202
(Address)

SUBSCRIBED AND SWORN TO before me this 24th day of January, 19 66

My commission expires April 30, 1967
Betty Brandt
Betty Brandt Notary Public

ROTARY DRILLERS' LOG

OPERATOR: J. C. Graves and Nadel & Gussman
412 Union Center
Wichita, Kansas

DRILLING COMMENCED: January 14, 1966

CONTRACTOR: Graves Drilling Co., Inc.
412 Union Center
Wichita, Kansas

DRILLING COMPLETED: January 20, 1966

CASING RECORD: 10 Jts. 219' 8-5/8"
cemented with 175 sacks

LOCATION: Dobrinski No. 1
NW SW NW
Section 9-18S-8W
Rice County, Kansas

0 - 219 Soil & shale
219 - 1033 Shale
1033 - 1290 Shale & lime
1290 - 1835 Lime & shale
1835 - 2235 Shale & shells
2235 - 2575 Shale
2575 - 3020 Shale & lime
3030 - 3186 Lime
3186 - 3361 Lime & shale
3361 - 3445 Shale & lime
3445 - 3517 Lime & shale
3517 Rotary Total Depth

RECEIVED
STATE CORPORATION COMMISSION
JAN 25 1966
CONSERVATION DIVISION
Wichita, Kansas

I hereby certify the foregoing statements to be true and correct to the best of my knowledge.

GRAVES DRILLING CO., INC.

By John C. Graves
President

STATE OF KANSAS)
) SS:
BUTLER COUNTY)

Subscribed and sworn to before me, a Notary Public, this 24th of January, 1966.

My commission expires:
April 30, 1967

Betty Brandt
Betty Brandt Notary Public