


STATE OF KANSAS
STATE CORPORATION COMMISSION

WELL PLUGGING RECORD
OR
FORMATION PLUGGING RECORD

Strike out upper line
when reporting plug-
ging off formations.

Give All Information Completely
Make Required Affidavit
Mail or Deliver Report to
Conservation Division
State Corporation Commission
800 Bitting Building
Wichita, Kansas

NORTH

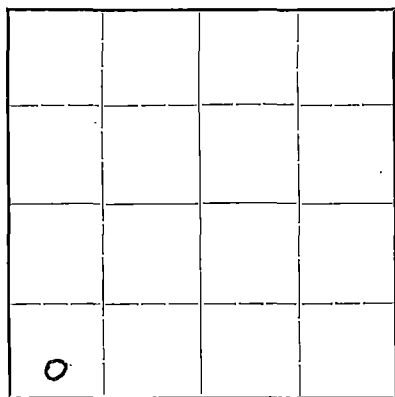

Locate well correctly on above
Section Plat

Rice County, Sec. 8 Twp. 18 Rge. (E) 8 (W)
Location as "NE $\frac{1}{4}$ NW $\frac{1}{4}$ SW $\frac{1}{4}$ " or footage from lines Center S $\frac{1}{2}$ SW $\frac{1}{2}$ SW $\frac{1}{2}$
Lease Owner Nelson Drilling Company
Lease Name Skiles Well No. 1
Office Address 508 Wolcott Bldg., Hutchinson, Kansas
Character of Well (completed as Oil, Gas or Dry Hole) Dry Hole
Date well completed December 11, 1941 19
Application for plugging filed December 11, 1941 19
Application for plugging approved December 11, 1941 19
Plugging commenced December 11, 1941 19
Plugging completed December 11, 1941 19
Reason for abandonment of well or producing formation Dry

If a producing well is abandoned, date of last production 19
Was permission obtained from the Conservation Division or its agents before plugging was com-
menced? yes

Name of Conservation Agent who supervised plugging of this well Durkey
Producing formation Depth to top Bottom Total Depth of Well 3020 Feet
Show depth and thickness of all water, oil and gas formations.


OIL, GAS OR WATER RECORDS

CASING RECORD

Formation	Content	From	To	Size	Put In	Pulled Out
K.C. Lime	Dry	2878'	3020'	10"	109'	

Describe in detail the manner in which the well was plugged, indicating where the mud fluid was placed and the method or methods used in introducing it into the hole. If cement or other plugs were used, state the character of same and depth placed, from feet to feet for each plug set.

Pumped hole full of mud. Plug at 200' from top of hole. 15 sacks cement finished filling hole with mud within 10' of top, finished filling hole to top with cement welded steel plate on top of surface pipe.

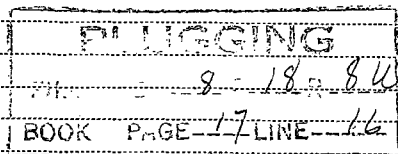

(If additional description is necessary, use BACK of this sheet)

Correspondence regarding this well should be addressed to Nelson Drilling Company
Address 508 Wolcott Bldg. Hutchinson, Kansas

STATE OF _____, COUNTY OF _____, ss.
_____ (employee of owner) or (owner or operator) of the above-described well,
being first duly sworn on oath, says: That I have knowledge of the facts, statements, and matters herein contained and the log of the above-described well as filed and that the same are true and correct. So help me God.

(Signature) *L. L. Nelson*
(Address)

SUBSCRIBED AND SWORN to before me this 19 day of December, 1941

Margaret J. Heyard
Notary Public.

My commission expires Mar. 10, 1945



COMPANY: C. C. Nelson Drilling Company
 CONTRACTOR: C. C. Nelson Drilling Company
 FARM: Skiles #1
 LOCATION: Section 8-18-8
 Rice County, Kansas
 COMMENCED: December 1, 1941
 COMPLETED: December 11, 1941

)			
0	to	75	Surface
75	to	107	Reaming surface hole
107	to	135	Shale and shells
135	to	330	Sticky shale
330	to	370	Red Bed
370	to	425	Anhydrite
425	to	725	Shale
725	to	1080	Red Bed, Shale and salt
1080	to	1095	Shale
1095	to	1210	Lime
1210	to	1270	Lime-Sharp
1270	to	1350	Lime and shale
1350	to	2025	Lime and shale
2025	to	2150	Shale and shells
2150	to	2283	Shale and lime
2283	to	2370	Shale
2370	to	2465	Lime
2465	to	2490	Lime and shale
2490	to	2515	Lime
2515	to	2555	Lime and shale
2555	to	2616	Lime
2616	to	2823	Lime and shale
2823	to	2875	Shale and shells
2875	to	2878	Lime and shale
2878	to	2888	K.C. Lime
2888	to	2896	Coring
2896	to	2898	Coring-8 ft. recovery
2898	to	2907	Coring-7 ft. recovery
2907	to	2980	K.C. Lime
2980	to	2987	Soft Break
2987	to	3020	Lime
<hr/>			
		2878	K.C. Lansing Lime
2878	to	2886	Lime
2886	to	2896	Lime core-hard and dry
2896	to	2898	Hard Lime
2898	to	2905	Lime core, porous and dry
2905	to	3020	Lime
<hr/>			
Total depth		3020	

PLUGGING
 FILE SEC-8 F-18 R-8U
 BOOK PAGE-27 LINE-16

Set 109 ' 10" surface pipe

C E R T I F I C A T E

I, C. C. Nelson, do hereby certify that the above foregoing is a true and correct copy of log of the Skiles No. 1 Well, located in the Center Half (C/2) of the Southwest Quarter (SW/4) of Section Eight (8), Township Eighteen (18), Range Eight (8), Rice County, Kansas, as reflected by files of the C. C. Nelson Drilling Company.

C. C. Nelson
 DEC 20 1941

Subscribed and sworn to before me, a Notary Public, within and for Reno County, Kansas, this 19 day of December 1941.

Margaret S. Hayford
 Notary Public