


WELL PLUGGING RECORD

Give All Information Completely  
Make Required Affidavit  
Mail or Deliver Report to:  
Conservation Division  
State Corporation Commission  
800 Bittling Building  
Wichita, Kansas

NORTH

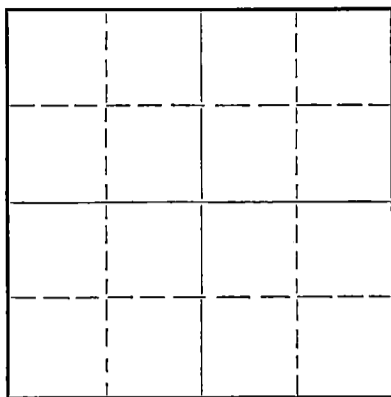

Locate well correctly on above  
Section Plat

Rice County, Sec. 7 Twp. 18 Rge. 8 (E) (W)  
Location as "NE/CNW $\frac{1}{4}$ SW $\frac{1}{4}$ " or footage from lines SE SW SE  
Lease Owner A. J. Stormfeltz  
Lease Name Jansen Well No. 1  
Office Address 4638 J. C. Nichols Parkway  
Character of Well (completed as Oil, Gas or Dry Hole) Dry  
Date well completed 11-10 19 52  
Application for plugging filed 11-10 19 "  
Application for plugging approved " 19 "  
Plugging commenced " 19 "  
Plugging completed " 19 "  
Reason for abandonment of well or producing formation

If a producing well is abandoned, date of last production 19  
Was permission obtained from the Conservation Division or its agents before plugging was commenced?

Name of Conservation Agent who supervised plugging of this well  
Producing formation Depth to top Bottom Total Depth of Well 3223 Feet  
Show depth and thickness of all water, oil and gas formations.

OIL, GAS OR WATER RECORDS

CASING RECORD

Formation	Content	From	To	Size	Put In	Pulled Out
				8 5/8	208	none

Describe in detail the manner in which the well was plugged, indicating where the mud fluid was placed and the method or methods used in introducing it into the hole. If cement or other plugs were used, state the character of same and depth placed, from feet to feet for each plug set.

Filled hole full heavy mud to within 208 feet of top, drove wooden plug to 208 feet and dumped in 20 sacks cement. Finished filling hole full heavy mud to within 235 feet of cellar and dumped in 5 sacks cement.

RECEIVED  
STATE CORPORATION COMMISSION  
NOV 17 11-19-1952  
CONSERVATION DIVISION  
WICHITA, KANSAS

(If additional description is necessary, use BACK of this sheet)  
Name of Plugging Contractor Mallard Drilling Company  
Address 1016 Union National Bank

STATE OF Kansas, COUNTY OF Sedgwick, ss.  
C. C. Nelson, partner Mallard Drg. Co. (employee, or owner) or (owner, or operator) of the above-described well, being first duly sworn on oath, says: That I have knowledge of the facts, statements, and matters herein contained and the log of the above-described well as filed and that the same are true and correct. So help me God.

(Signature) C. C. Nelson

(Address)

SUBSCRIBED AND SWORN TO before me this 17th day of Nov 1952

My commission expires 12/4/52

23-8390-s 6-51-20M

Notary Public.

PLUGGING  
FILE SEC 7 T 18 R 82  
BOOK PAGE 58 LINE 45

COMPANY: A. J. Stormfeltz  
 CONTRACTOR: Mallard Drilling Company  
 FARM: Jansen #1  
 LOCATION: SE SW SE - Sec. 7-18-8  
 Rice County  
 COMMENCED: November 1, 1952  
 COMPLETED: November 10, 1952

0	to	208	Shale
208	to	830	Shale
830	to	1200	Shale and lime
1200	to	1400	lime and sand
1400	to	1590	lime
1590	to	1690	lime
1690	to	2065	lime and shale
2065	to	2455	lime and shale
2455	to	2670	lime
2670	to	2745	lime
2745	to	2855	lime and shale
2855	to	2872	Shale
2872	to	2893	Brown lime
2893	to	2920	Kansas City
2920	to	2965	lime
2965	to	3043	lime
3043	to	3093	lime
3093	to	3153	lime
3153	to	3218	lime
3218	to	3223	lime
		3223	T.D.

Set 208 feet of 3 5/8" surface pipe. Cemented with 135 sacks cement.

TOPS: K. O. -- 2893

No hole drilled with cardwell.  
 Measurements taken from derrick floor.

DRY, ABANDONED AND PLUGGED

RECEIVED  
 STATE CORPORATION COMMISSION  
 NOV 15 1952  
 CONSERVED

C E R T I F I C A T E

I, C. C. Nelson, do hereby certify that the above and foregoing is a true and correct copy of log of the Jansen #1, Sec. 7-18-8, Rice County, Kansas, as reflected by filed of the Mallard Drilling Company.

*C. C. Nelson*

Subscribed and sworn to before me a Notary Public, within and for Sedgwick County, Kansas, this 17th day of November 1952.

*Raymond Wright*

My commission expires 12/4/52

**PLUGGING**  
 FILE SEC 7-18-8  
 BOOK PAGE 58 LINE 45