


STATE OF KANSAS  
STATE CORPORATION COMMISSION

WELL PLUGGING RECORD

Give All Information Completely  
Make Required Affidavit  
Mail or Deliver Report to:  
Conservation Division  
State Corporation Commission  
211 No. Broadway  
Wichita, Kansas

NORTH

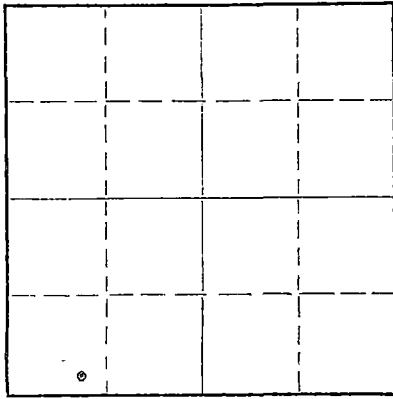

Locate well correctly on above  
Section Plat

Rice County. Sec. 1 Twp. 18 Rge. 8 (E) W(W)  
Location as "NE/CNW/SW" or footage from lines SE SW SW  
Lease Owner Frank J. Black  
Lease Name Maupin Well No. 1  
Office Address 600 Washington, McPherson Kans.  
Character of Well (completed as Oil, Gas or Dry Hole) Oil well  
Date well completed April 27 1951  
Application for plugging filed Nov. 6 1956  
Application for plugging approved Nov. 7 1956  
Plugging commenced Nov. 8 1956  
Plugging completed Nov. 15 1956  
Reason for abandonment of well or producing formation \_\_\_\_\_

Non-Commercial  
If a producing well is abandoned, date of last production October 1956  
Was permission obtained from the Conservation Division or its agents before plugging was commenced? Yes

Name of Conservation Agent who supervised plugging of this well Ruel Durkee  
Producing formation Conglomerate Depth to top 3200 Bottom 3241 Total Depth of Well 3270 Feet  
Show depth and thickness of all water, oil and gas formations.

OIL, GAS OR WATER RECORDS

CASING RECORD

FORMATION	CONTENT	FROM	TO	SIZE	PUT IN	PULLED OUT
Surface soil		0	220	8 5/8"	220'	None
Red bed		220	490			
Shale		490	840	5 1/2"	3270'	2683'
Salt		840	1005			
Lime & Shale & sd		1005	2802			
Lime		2802	3200			
Congl.		3200	3241			

Describe in detail the manner in which the well was plugged, indicating where the mud fluid was placed and the method or methods used in introducing it into the hole. If cement or other plugs were used, state the character of same and depth placed, from \_\_\_\_\_ feet to \_\_\_\_\_ feet for each plug set.

Filled hole with sand from T.D. to 3010 ft.  
Dumped 6 sacks of cement at 3010', making cement plug from 3010 to 2945'  
Mudded hole  
Attempted to cut pipe off at 2800' -- Found cement on outside of pipe  
Succeeded in cutting pipe off at 2683' -- Pulled same.  
Finished mudding hole to 220'  
Set bridge with top at 210'  
Dumped 15 sacks of cement at 210' -- Mudded hole to within 30' of surface.  
Dumped 5 sacks of cement from 30' to bottom of cellar

(If additional description is necessary, use BACK of this sheet)  
Name of Plugging Contractor Wiggins & Lamb Pipe Pulling Co.  
Address P.O. Box 191, McPherson Kansas

STATE OF Kansas, COUNTY OF McPherson, ss.  
\_\_\_\_\_  
(employee of owner) or (owner or operator) of the above-described well, being first duly sworn on oath, says: That I have knowledge of the facts, statements, and matters herein contained and the log of the above-described well as filed and that the same are true and correct. So help me God.

(Signature) [Signature]  
(Address) \_\_\_\_\_

SUBSCRIBED AND SWORN TO before me this 19 day of Nov 1956  
[Signature]  
Notary Public.

My commission expires \_\_\_\_\_

PLUGGING  
FILE SEC 1 T. 18 R. 8W  
BOOK PAGE 114 LINE 9

RECEIVED  
STATE CORPORATION COMMISSION  
NOV 21 1956  
11-20-1956  
CONSERVATION DIVISION  
Wichita, Kansas

WELL LOG BUREAU - KANSAS GEOLOGICAL SOCIETY

508 East Murdock

Wichita, Kansas 15.159.00217.00.00


Company - DOZIER OIL CO.  
Farm - Maupin No. 1

SEC. 1 T. 18 R. 8W  
SE SW SW

Total Depth. 3270  
Comm. 4-18-51 Comp. 4-27-51  
Shot or Treated.  
Contractor. Stag Drilling Co.  
Issued. 6-30-51

County. Rice

KANSAS

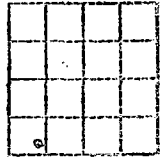

Elevation. 1747

Production. 30 BO & 70% wtr

Figures Indicate Bottom of Formations.

surface soil	220
red bed, shale, shells	490
shale, shells	840
salt	1005
shale, shells	1035
lime, shale	1110
sandy lime	1145
lime, shale	1880
shale, shells	2350
lime, shale	2405
lime	2675
shale	2679
shale, lime	2802
lime	3139
lime, shale	3207
congl.	3262
viola	3270
Total Depth	

Scout Tops:	
Heebner	2676
Brown Lime	2802
Lansing	2830
Conglomerate	3200
Kinderhook	3241
Viola	3262

All measurements from top of rotary bushing.

**RECEIVED**  
STATE COMMISSION  
NOV 19 1956  
CONSERVATION DIVISION  
Wichita, Kansas

**RECEIVED**  
STATE COMMISSION

CONSERVATION DIVISION  
WICHITA, KANSAS

**RECEIVED**  
STATE COMMISSION

*Miggins & Lamb*  
P.O. 35-8

**PLUGGING**  
FILE SEC 1 T 18 R 8W  
BOOK PAGE 114 9