

STATE OF KANSAS
STATE CORPORATION COMMISSION

Form CP-4

WELL PLUGGING RECORD

Give All Information Completely
Make Required Affidavit
Mail or Deliver Report to:
Conservation Division
State Corporation Commission
212 No. Market
Wichita, Kansas

Rice County, Sec. 1 Twp. 18 Rge. 8 (E) (W)

Location as "NE/CNW/SW" or footage from lines SE SW SE

Lease Owner Leo Michaelis

Lease Name Baine Well No. 1

Office Address R. R. #2 Russell, Kansas

Character of Well (completed as Oil, Gas or Dry Hole)

Date well completed 19

Application for plugging filed 19

Application for plugging approved 19


Plugging commenced 10-30-67 19

Plugging completed 11-8-67 19

Reason for abandonment of well or producing formation

If a producing well is abandoned, date of last production 19

Was permission obtained from the Conservation Division or its agents before plugging was commenced? Yes

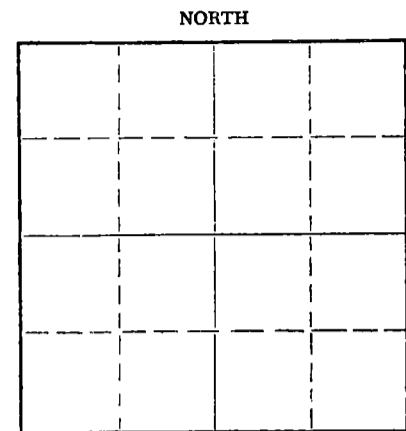

Locate well correctly on above Section Plat

Name of Conservation Agent who supervised plugging of this well Gilbert Toman

Producing formation Depth to top Bottom Total Depth of Well 3339 Feet

Show depth and thickness of all water, oil and gas formations.

OIL, GAS OR WATER RECORDS

CASING RECORD

FORMATION	CONTENT	FROM	TO	SIZE	PUT IN	PULLED OUT
				8 5/8	299	None
				4 1/2	None	745
RECEIVED STATE CORPORATION COMMISSION JAN - 8 1968 CONSERVATION DIVISION Wichita, Kansas 1-8-1968						

Describe in detail the manner in which the well was plugged, indicating where the mud fluid was placed and the method or methods used in introducing it into the hole. If cement or other plugs were used, state the character of same and depth placed, from feet to feet for each plug set.

Moved in casing pulling machine. Moved pumping unit and rods.

Cleaned out cellard. Welded on 4 1/2 collar.

Sanded to 3200'. Dumped 4 sacks of cement. Working pipe. Shot pipe at 2800'.

Circulating. Spotted 65 bbl of oil.

Working pipe. Pulling pipe.

Bailing. Plugging well. Set rock bridge at 235'. Dumped 25 sacks of cement. Mudded hole and rock bridge. Capped well with 10 sacks of cement.

(If additional description is necessary, use BACK of this sheet)

Name of Plugging Contractor Forbes Casing Pulling, Inc.

Address P. O. Box 221 Great Bend, Kansas

STATE OF Kansas, COUNTY OF Barton, ss.

J. O. Forbes

(employee of owner) or (owner or operator) of the above-described well, being first duly sworn on oath, says: That I have knowledge of the facts, statements, and matters herein contained and the log of the above-described well as filed and that the same are true and correct. So help me God.

(Signature) J. O. Forbes

P. O. Box 221 Great Bend, Kansas

(Address)

SUBSCRIBED AND SWORN TO before me this 10 day of November, 19 67

My commission expires May 27, 1969

Notary Public.