

STATE OF KANSAS
STATE CORPORATION COMMISSION


Give All Information Completely
Make Required Affidavit
Main Report to:
Conservation Division
State Corporation Commission
800 Bittling Building
Wichita, Kansas

WELL PLUGGING RECORD

Rice County, Sec. 1 Twp. 18 Rge. (E) 8 (W)

Location as "NE/CNW/SW" or footage from lines SE¹/₄ SW¹/₄ SE¹/₄
Lease Owner Lewis Drilling Co.
Lease Name Bain Well No. 1
Office Address 607 Union National Bank Bldg., Wichita, Kansas
Character of Well (completed as Oil, Gas or Dry Hole) Dry Hole
Date well completed 1-3 1953
Application for plugging filed 1-3 1953
Application for plugging approved 1-5 1953
Plugging commenced 1-3 1953
Plugging completed 1-3 1953
Reason for abandonment of well or producing formation

NORTH

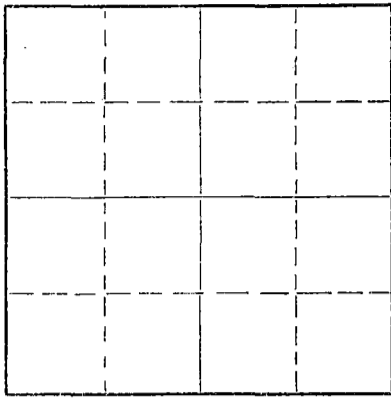

Locate well correctly on above
Section Plat

If a producing well is abandoned, date of last production 19
Was permission obtained from the Conservation Division or its agents before plugging was commenced? Yes

Name of Conservation Agent who supervised plugging of this well Mr. Ruel Durkee
Producing formation Depth to top Bottom Total Depth of Well 3340 Feet
Show depth and thickness of all water, oil and gas formations.

OIL, GAS OR WATER RECORDS

CASING RECORD

FORMATION	CONTENT	FROM	TO	SIZE	PUT IN	PULLED OUT
				8-5/8"	237'	None

Describe in detail the manner in which the well was plugged, indicating where the mud fluid was placed and the method or methods used in introducing it into the hole. If cement or other plugs were used, state the character of same and depth placed, from feet to feet for each plug set.

15 Sx Cement @ 237'
10 Sx Cement on Top

RECEIVED
STATE CORPORATION COMMISSION
JAN 9 - 1953
1-9-1953
CONSERVATION DIVISION
Wichita, Kansas

(If additional description is necessary, use BACK of this sheet)

Name of Plugging Contractor Lewis Drilling Co.
Address 607 Union National Bank Bldg., Wichita, Kansas

STATE OF KANSAS, COUNTY OF SEDGWICK, ss.
L. L. Bailey (employee of owner) or (owner or operator) of the above-described well, being first duly sworn on oath, says: That I have knowledge of the facts, statements, and matters herein contained and the log of the above-described well as filed and that the same are true and correct. So help me God.

(Signature) L. L. Bailey
607 Union National Bank Bldg., Wichita, Kansas
(Address)

SUBSCRIBED AND SWORN TO before me this 7 day of January, 1953

Arthur R. Derrington
Notary Public.

My commission expires August 20, 1956

PLUGGING
FILE SEC 1 T 18 R 83
BOOK PAGE 28 LINE 7

WELL LOG

COMPANY Lewis Drilling Co., et al

SEC. 1 T. 18 R. 8W

FARM Bain

NO. 1

LOG. SE¹/₄ SW¹/₄ SE¹/₄

TOTAL DEPTH 3340'

COMM. 12-5-52


COMP. 1-3-53

SHOT OR TREATED

CONTRACTOR Lewis Drilling Co.

ISSUED

COUNTY Rice KANSAS

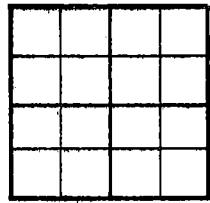

CASING

20	10
15	XX 8-5/8" 237'
12	6
13	5

ELEVATION 1736 RB

PRODUCTION

FIGURES INDICATE BOTTOM OF FORMATIONS

0 - 545	Red Bed & Blue Shale
545 - 1435	Shale & Shells
1435 - 1745	Lime & Shale.
1745 - 2275	Shale
2275 - 2890	Lime & Shale
2890 - 3205	Lime
3205 - 3238	Lime & Conglomerate
3238 - 3340	Conglomerate
3340 - TD	

GEOLOGICAL TOPS

Heebner	2690
Brown Lime	2818
Lansing	2845
Conglomerate	3246

STATE CORPORATION COMMISSION
 JAN 9 - 1953
 CONSERVATION DIVISION
 (Wichita, Kansas)

State of KANSAS }
 County of SEDGWICK } SS:

I, L. L. Bailey of the Lewis Drilling Company

upon oath state that the above and foregoing is a true and correct copy of the log of the Bain #1 well.

L. L. Bailey

Subscribed and sworn to before me this 7 day of January 1953

My Commission Expires: August 20, 1956

Arthur P. Herrington
 NOTARY PUBLIC

PLUGGING
 ALL SEC 1 T 18 R 8W
 BOOK PAGE 20 LINE 24