

RECEIVED
STATE CORPORATION COMMISSION

JUN 28 1974
1-28-1974

STATE OF KANSAS
STATE CORPORATION COMMISSION


Take All Information Completely
Make Required Affidavit
Mail or Deliver Report to
Conservation Division
State Corporation Commission

P. O. Box 17027
Wichita, Kansas 67217

WELL PLUGGING RECORD
CONSERVATION DIVISION
Wichita, Kansas

Rice County, Sec 33 Twp. 18 Rge 7 (X) W (W)

Location as "NE/CNWSWS" or footage from lines NW SW NW
Lease Owner National Development Co.
Lease Name HILL Well No. 2
Office Address 1300 Union National Bldg., Wichita, Ks. 67202
Character of Well (completed as Oil, Gas or Dry Hole) Dry Hole
Date well completed June 27 19 74
Application for plugging filed June 27 19 74
Application for plugging approved June 27 19 74
Plugging commenced June 27 19 74
Plugging completed June 27 19 74
Reason for abandonment of well or producing formation

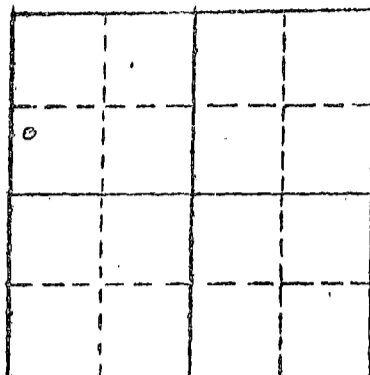

Locate well correctly on above
Section Plot

If a producing well is abandoned, date of last production 19
Was permission obtained from the Conservation Division or its agents before plugging was com-
menced? yes

Name of Conservation Agent who supervised plugging of this well Hugh Scott
Producing formation Depth to top Bottom Total Depth of Well 3300 Feet
Show depth and thickness of all water, oil and gas formations.

OIL, GAS OR WATER RECORDS

CASING RECORD

FORMATION	CONTENT	FROM	TO	SIZE	PUT IN	PULLED OUT

Describe in detail the manner in which the well was plugged, indicating where the mud fluid was placed and the method or methods used in introducing it into the hole. If cement or other plugs were used, state the character of same and depth placed, from feet to feet for each plug set.

Hole full of heavy mud to 250'.
Set Plug & 25 sacks cement thru drill pipe.
Come up hole to 40', set plug, 1/2 sacks hulls, 10 sacks cement thru drill
2 sacks in rat hole

Name of Plugging Contractor Duke Drilling Co. (If additional description is necessary, use BACK of this sheet)
Address Box 823 - Great Bend, Ks.

STATE OF Kansas COUNTY OF Barton 58.
Larry Curtis (employee of owner) or ~~owner~~ of the above-described

well, being first duly sworn on oath, says: That I have knowledge of the facts, statements, and matters herein contained and the log of the above-described well as filed and that the same are true and correct. So help me God.

(Signature) Larry Curtis
Box 823 - Great Bend, Kansas 67530 (Address)

Subscribed and Sworn to before me this 27 day of June 19 74.

Notary Public.

RECEIVED
STATE CORPORATION COMMISSION

JUN 28 1974

DRILLERS' WELL LOG

DATE COMMENCED: June 21, 1974
DATE COMPLETED: June 27, 1974

National Conservation Commission
HILL #2 Wichita, Kansas
NW SW NW
Section 33-T18-R7W
Rice County, Kansas

0	185'	Clay & Blue Shale
185	- 216'	Sand
216	- 1009'	Red Bed
1009	- 1049'	Anhydrite
1049	- 1380'	Shale
1380	- 1765'	Lime & Shale
1765	- 2435'	Shale
2435	- 2632'	Lime
2632	- 2637'	Shale
2637	- 2669'	Lime & Shale
2669	- 2770'	Shale
2770	- 3240'	Lime
3240	- 3300'	Conglomerate
	3300'	RTD

ELEVATION: 1702 K.B.

FORMATION DATA

Anhydrite	1009
Heebner	2632
Toronto	2647
Douglas	2669
Brown Lime	2770
Kansas City	2801
Conglomerate	3240
RTD	3300

Surface Pipe: Set used 8-5/8"
28# pipe at 237' with 150
sacks common, 3% cc.

A F F I D A V I T

STATE OF KANSAS
COUNTY OF BARTON) ss.

Larry Curtis of lawful age does swear and state that the facts and statements herein contained are true and correct to the best of his knowledge.

Larry Curtis

Subscribed and sworn to before me this 27 day of June 1974.

My Comm. Expires:

April 11, 1978

Harvey M. Hague
Notary Public