

STATE OF KANSAS
STATE CORPORATION COMMISSION

WELL PLUGGING RECORD

All Information Completely
Required Affidavit
or License Report to:
Conservation Division
State Corporation Commission
211 No. Broadway
Wichita, Kansas

Rice County. Sec. 13 Twp. 19S Rge. 8 (E) W (W)

Location as "NE/CNW/SW" or footage from lines NW/4 SE/4 SE/4

Lease ~~Owner~~ Operator: Birmingham-Bartlett Drilling Co.

Lease Name Wieland Well No. 1

Office Address 300 Kaufman Bldg., Wichita 2, Kansas

Character of Well (completed as Oil, Gas or Dry Hole) Dry Hole

Date well completed November 1, 1957

Application for plugging filed (verbal) November 1, 1957

Application for plugging approved (verbal) November 1, 1957


Plugging commenced November 1, 1957

Plugging completed November 1, 1957

Reason for abandonment of well or producing formation Dry Hole

If a producing well is abandoned, date of last production 19

Was permission obtained from the Conservation Division or its agents before plugging was commenced? Yes

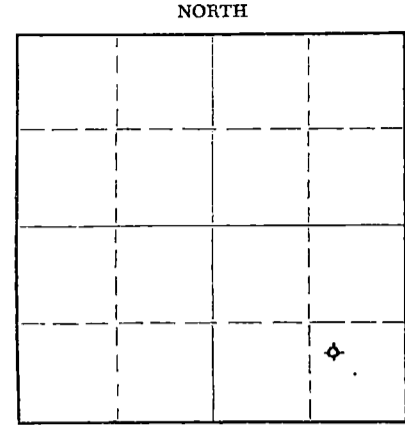

Locate well correctly on above
Section Plat

Name of Conservation Agent who supervised plugging of this well Ruel Durkee

Producing formation _____ Depth to top _____ Bottom _____ Total Depth of Well 3530 Feet

Show depth and thickness of all water, oil and gas formations.

OIL, GAS OR WATER RECORDS

CASING RECORD

FORMATION	CONTENT	FROM	TO	SIZE	PUT IN	PULLED OUT
		0	285'	8-5/8"	285'	none

Describe in detail the manner in which the well was plugged, indicating where the mud fluid was placed and the method or methods used in introducing it into the hole. If cement or other plugs were used, state the character of same and depth placed, from _____ feet to _____ feet for each plug set.

15 sacks cement mixed and poured through drill pipe on bottom plug set at 220'. 10 sacks cement mixed and poured on top plug set at 40'. Filled with mud to surface.

NOV 5
CONSERVATION DIVISION
WICHITA, KANSAS

(If additional description is necessary, use BACK of this sheet)
Name of Plugging Contractor Birmingham-Bartlett Drilling Co. 11-5-1957
Address 300 Kaufman Bldg., Wichita 2, Kansas

STATE OF Kansas, COUNTY OF Sedgwick
Richard Hindery, partner of Birmingham-Bartlett Drilling Co., operator and contractor (employee of owner) or (owner or operator) of the above-described well, being first duly sworn on oath, says: That I have knowledge of the facts, statements, and matters herein contained and the log of the above-described well as filed and that the same are true and correct. So help me God. BIRMINGHAM-BARTLETT DRILLING CO.
(Signature) By Richard Hindery Partner
300 Kaufman Bldg., Wichita 2, Kansas (Address)

SUBSCRIBED AND SWORN TO before me this 4th day of November, 1957.
Beverly Larson
Beverly Larson Notary Public.
My commission expires October 2, 1958.

PLUGGING
FILE SEC 13 T 19 R 8W
BOOK PAGE 58 LI E 42

WIELAND NO. 1 WELL

LOCATION: NW/4 SE/4 SE/4 Section 13-19S-8W Rice County, Kansas

SPUDED: 10-21-57
COMPLETED: 11-1-57

OPERATOR and CONTRACTOR: Birmingham-Bartlett Drilling Co. 300 Kaufman Building Wichita 2, Kansas

SURFACE CASING: 8-5/8" casing cemented at 285' with 200 sacks cement and 4 c.c.

OIL STRING: None set. Dry and abandoned.

L O G

(Figures indicate bottom of formation)

0	80	Clay sand
	285	Shale
	290	Red bed
	305	Anhydrite
	1075	Shale and shells
	2900	Lime and shale
	3275	Lime
	3400	Shale
	3440	Shale and lime
	3471	Viola lime and shale
	3509	Shale
	3530	Arbuckle
	3530	Rotary total depth

The undersigned, Richard Hindery, one of the partners of Birmingham-Bartlett Drilling Co., hereby certifies that the above is a true and correct log of the formations encountered in drilling the Wieland No. 1 Well as shown in the daily drilling reports.

BIRMINGHAM-BARTLETT DRILLING CO.

By Richard Hindery

Subscribed and sworn to before me this 4th day of November 1957.

Beverly Larson
Notary Public

My commission expires October 2, 1958.

DRILLING
 W. 13-19 S. 8 W.
 BOOK PAGE 58 LINE 42