


STATE OF KANSAS
STATE CORPORATION COMMISSION

WELL PLUGGING RECORD

Give All Information Completely
Make Required Affidavit
Mail or Deliver Report to:
Conservation Division
State Corporation Commission
800 Bitting Building
Wichita, Kansas

NORTH

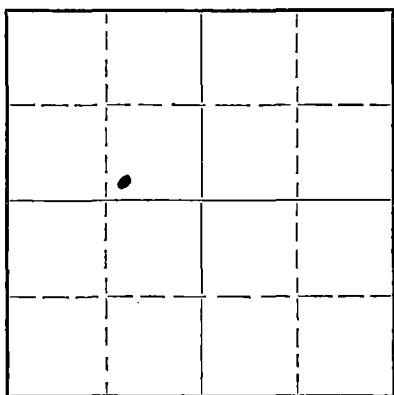

Locate well correctly on above
Section Plat

RICE County. Sec. 11 Twp. 19 Rge. 8 (E) (W)
Location as "NE/CNW 1/4 SW 1/4" or footage from lines SW SE NW
Lease Owner Hummon Oil, Inc.
Lease Name Potter Well No. 1
Office Address Wichita, Kansas
Character of Well (completed as Oil, Gas or Dry Hole) Dry Hole
Date well completed November 17 1966
Application for plugging filed November 17 1966
Application for plugging approved November 17 1966
Plugging commenced November 17 1966
Plugging completed November 17 1966
Reason for abandonment of well or producing formation

If a producing well is abandoned, date of last production 19
Was permission obtained from the Conservation Division or its agents before plugging was commenced? Yes

Name of Conservation Agent who supervised plugging of this well Gilbert Truan
Producing formation Depth to top Bottom Total Depth of Well 3310 Feet
Show depth and thickness of all water, oil and gas formations.

OIL, GAS OR WATER RECORDS

CASING RECORD

Formation	Content	From	To	Size	Put In	Pulled Out

Describe in detail the manner in which the well was plugged, indicating where the mud fluid was placed and the method or methods used in introducing it into the hole. If cement or other plugs were used, state the character of same and depth placed, from feet to feet for each plug set.

Set plug and hulls and 20 sacks of cement through drill pipe at 190'.

Set plug and hulls and 10 sacks of cement at 40'.

Put 2 sacks of cement in rat hole.

DEC 2 1966
CONSERVATION DIVISION
WICHITA, KANSAS
12-2-1966

(If additional description is necessary, use BACK of this sheet)
Correspondence regarding this well should be addressed to Hummon Oil, Inc.
Address 821 Union National Bldg., Wichita, Kansas 67202

STATE OF KANSAS, COUNTY OF BARTON, ss.
Duke C. Burt (employee of owner) or (owner or operator) of the above-described well, being first duly sworn on oath, says: That I have knowledge of the facts, statements, and matters herein contained and the log of the above-described well as filed and that the same are true and correct. So help me God.

(Signature) *Duke C. Burt*
1823 Washington, Great Bend, Kansas 67530
(Address)

SUBSCRIBED AND SWORN TO before me this 30th day of November, 1966
Edwin H. Mauler

My commission expires July 2, 1969 Notary Public.

HUMMON OIL CO.
821 Union National Bldg.
Wichita, Kansas

Well: Potter No. 1
Commenced R. D.: 11/ 9/66
Completed R. D.: 11/18/66
Total Depth: 3310' D. F.
Casing: Ran 196' of 8 5/8" 8rd thd.
Surface Pipe

Sec.: 11-19-8W
Rice County, Kansas
Elevation:
Initial Prod.: D & A
Contractor: BURT DRILLING
COMPANY

Strata	Depth
Shale & Shells	0- 140'
Blue Shale	140- 196
Shale & Shells	196-1080
Lime & Shale	1080-1145
Lime & Shale Streaks	1145-1639
Lime w/Shale Streaks	1639-1768
Shale w/Lime Streaks	1768-2160
Shale & Lime	2160-2260
Lime & Shale	2260-2676
Lime	2676-2693
Shale	2693-2720
Shale & Lime	2720-2800
Lime	2800-3170
Lime & Shale	3170-3220
Lime	3220-3248
Lime, Shale & Sand	3248-3268
Lime & Shale	3268-3310

I hereby certify that the above is a true and correct log of said well as reflected by daily reports.

BURT DRILLING CO.

[Signature]

Signed and sworn in my presence this 21st day of November, 1966.

[Signature]

My Commission Expires: October 15, 1967

RECEIVED
STATE CONSERVATION COMMISSION
DEC 2 1966
CONSERVATION DIVISION
Wichita, Kansas