


STATE OF KANSAS
STATE CORPORATION COMMISSION

Give All Information Completely
Make Required Affidavit
Mail or Deliver Report to:
Conservation Division
State Corporation Commission
800 Bitting Building
Wichita, Kansas

WELL PLUGGING RECORD
OR
FORMATION PLUGGING RECORD

Strike out upper line
when reporting plug-
ging off formations.

NORTH

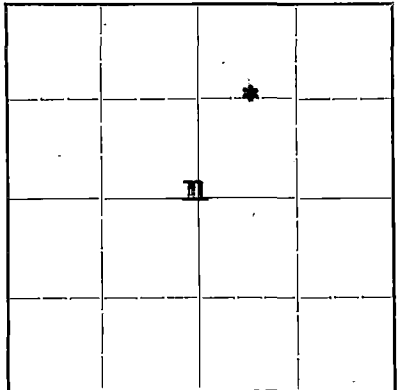

Locate well correctly on above
Section Plat

Rice County. Sec. 11 Twp. 19 Rge. (E) 8 (W)
Location as "NE 1/4 NW 1/4 SW 1/4" or footage from lines. 1320 N-660 E of center of Sec. 11
Lease Owner. Cities Service Gas Co.
Lease Name. Ellis Well No. 1
Office Address. Bartlesville, Oklahoma
Character of Well (completed as Oil, Gas or Dry Hole) Dry Hole
Date well completed. 7-1 1942
Application for plugging filed. 7-1 1942
Application for plugging approved. 7-2 1942
Plugging commenced. 7-1 1942
Plugging completed. 7-1 1942
Reason for abandonment of well or producing formation. Dry Hole
If a producing well is abandoned, date of last production. 19
Was permission obtained from the Conservation Division or its agents before plugging was com-
menced? YES

Name of Conservation Agent who supervised plugging of this well. Ruel Durkee
Producing formation. Arbuckle Depth to top. 3294 Bottom. Total Depth of Well. 3324 Feet
Show depth and thickness of all water, oil and gas formations.

OIL, GAS OR WATER RECORDS

CASING RECORD


Formation	Content	From	To	Size	Put In	Pulled Out
				13"	221	None
				Cemented w/ 175 sacks.		

Describe in detail the manner in which the well was plugged, indicating where the mud fluid was placed and the method or methods used in introducing it into the hole. If cement or other plugs were used, state the character of same and depth placed, from _____ feet to _____ feet for each plug set.

Filled w/ heavy mud 3324' to 200'
Wood plug @ 200'
15 sacks cement 200' to 180'
Mud 180' to 15'
Wood plug @ 15'
8 sacks cement 15' to 4'

Cut casing off and welded on steel cap - 4' below surface.

7-23-1942

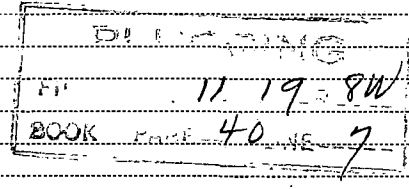

(If additional description is necessary, use BACK of this sheet)

Correspondence regarding this well should be addressed to R. C. Hauber
Address. Cities Service Oil Co.
Great Bend, Kansas

STATE OF Kansas COUNTY OF Barton, ss.

(employee of owner) or (owner or operator) of the above-described well,
being first duly sworn on oath, says: That I have knowledge of the facts, statements, and matters herein contained and the log of the above-described well as filed and that the same are true and correct. So help me God.

(Signature) *R. C. Hauber*
Chase, Kansas
(Address)

SUBSCRIBED AND SWORN TO before me this 6 day of July, 1942

My Commission Expires Sept. 26, 1942
My commission expires

Notary Public.

WELL RECORD

Company **Cities Service Gas Co.** Well No. **1** Farm **Ellis**
 Location **1320' north and 660' east of Center** Sec. **11** T. **19** R. **8-N**
 Elevation **1754** County **Wise** State **Kansas**
 Drlg. Comm. **June 15, 1942** Contractor **Herndon Drilling Company**
 Drlg. Comp. **June 30, 1942** Acid **None**
 T. D. **3324'** Initial Prod. **Dry - Plugged and Abandoned**

BAND RECORD:

12-1/2" @ 221' cemented with 175 sacks of cement

FORMATION RECORD:

shale	0-15
shale & sand	65
shale & shells	221
shale	290
shale & shells	910
salt, shells & shale	1070
lime & shale	1120
shale & shells	1290
broken lime & shale	1370
sand	1400
lime & shale	1590
shale & shells	1750
shale	1850
shale & shells	2100
lime & shells	2140
lime & shale	2205
shale & shells	2410
broken lime	2480
lime	2550
lime & shale	2650
broken lime	2715
shale & shells	2770
shale & lime	2850
lime	2885
broken lime	3050
lime	3201
conglomerate	3220
lime	3275
shale cored (rec. 5')	3280
cored shale & sand (rec. 1 1/2')	3290
cored shale & dolomite (rec. 5')	3297
lime	3324 T. D.

Top Lansing	2835'
Top Simpson	2866'
Top Arbuckle	3294'
Penetration	30'
Total Depth	3324'

Halliburton drill stem test, 3267-75, showed 45' rotary mud and very slight show gas in 30 minutes.

Cyfo:	500'	OK
	1000'	OK
	1500'	OK
	2000'	OK
	2500'	OK
	3000'	OK

PLUGGING
 FILE **11-19-R84**
 BOOK **PAGE 40** LINE **7**