


WELL PLUGGING RECORD

Give All Information Completely
Make Required Affidavit
Mail or Deliver Report to:
Conservation Division
State Corporation Commission
211 No. Broadway
Wichita, Kansas

RICE County. Sec. 1 Twp. 19S Rge. (E) 8W (W)

Location as "NE/CNW/SW" or footage from lines E/2 NW/4 SE/4
Lease Owner REX & MORRIS DRILLING COMPANY AND KENNETH RUFF
Lease Name BURDETTE "A" Well No. 1
Office Address P. O. BOX 334, EL DORADO, KANSAS 67042
Character of Well (completed as Oil, Gas or Dry Hole) DRY HOLE
Date well completed 14 AUGUST 19 63
Application for plugging filed 14 AUGUST 19 63
Application for plugging approved 14 AUGUST 19 63
Plugging commenced 14 AUGUST 19 63
Plugging completed 14 AUGUST 19 63
Reason for abandonment of well or producing formation DRY HOLE

NORTH

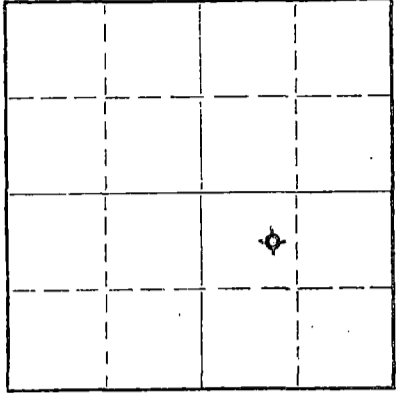

Locate well correctly on above
Section Plat

If a producing well is abandoned, date of last production NONE 19
Was permission obtained from the Conservation Division or its agents before plugging was commenced? YES

Name of Conservation Agent who supervised plugging of this well GILBERT TOMAN
Producing formation NONE Depth to top Bottom Total Depth of Well 3274 Feet
Show depth and thickness of all water, oil and gas formations.

OIL, GAS OR WATER RECORDS CASING RECORD

FORMATION	CONTENT	FROM	TO	SIZE	PUT IN	PULLED OUT
SURFACE HOLE	WATER	SURFACE	221' RB	8 5/8" OD	215.85'	LEFT IN
(SEE ATTACHED LOG)						

Describe in detail the manner in which the well was plugged, indicating where the mud fluid was placed and the method or methods used in introducing it into the hole. If cement or other plugs were used, state the character of same and depth placed, from _____ feet to _____ feet for each plug set.

FILLED HOLE WITH DRILLING MUD TO 205', SET PLUG AND CEMENTED WITH 20 SACKS CEMENT, FILLED HOLE WITH DRILLING MUD TO 35', SET PLUG AND CEMENTED WITH 10 SACKS CEMENT, PUT 2 SACKS CEMENT IN RAT HOLE.

RECEIVED
STATE CORPORATION COMMISSION
SEP 11 1963
CONSERVATION DIVISION
Wichita, Kansas
9-11-1963

(If additional description is necessary, use BACK of this sheet)
Name of Plugging Contractor REX & MORRIS DRILLING COMPANY
Address P. O. BOX 334, EL DORADO, KANSAS 67042

STATE OF KANSAS COUNTY OF BUTLER ss.
A. H. FISHER (employee of owner) or (owner or operator) of the above-described

well, being first duly sworn on oath, says: That I have knowledge of the facts, statements, and matters herein contained and the log of the above-described well as filed and that the same are true and correct. So help me God.

(Signature) *A. H. Fisher*
P. O. BOX 334, EL DORADO, KANSAS 67042
(Address)

SUBSCRIBED AND SWORN TO before me this 10TH day of SEPTEMBER, 1963

My commission expires 8 AUGUST 1966
ELIZABETH DESCHNER Notary Public.

BURDETTE "A" #1

Rex & Morris Drilling Co. and Kenneth Rupp

Total Depth: 3274
Contractor: Rex & Morris
Commenced: 8-8-63
Completed: 8-14-63
Initial Prod.: D. & A.

Location: E/2 NW/4 SE/4
Section 1-19S-2W
Rice County, Kansas

Casing Record:
8 5/8 @ 221' w/125 sacks

FORMATION	DEPTH
Surface Hole	221
Shale	290
Anhydrite	295
Shale	895
Shale and Lime	1480
Lime and Shale	2682
Shale and Sand	2808
Lime	3090
Lime and Shale	3200
Conglomerate	3254
Lime	3274

T.D.

RECEIVED
STATE CORPORATION COMMISSION

SEP 11 1963

CONSERVATION DIVISION
Wichita, Kansas

I hereby certify the foregoing statements are true and correct to the best of my knowledge and belief.

Rex & Morris Drilling Company

By Paul D. Koentz
Paul D. Koentz, Geologist

STATE OF KANSAS
COUNTY OF BUTLER, SS.

Subscribed and sworn to before me, a Notary Public, this 15th day of August, 1963.

Elizabeth Deschner
Elizabeth Deschner, Notary Public

My commission expires: August 8, 1966