

STATE OF KANSAS
STATE CORPORATION COMMISSION


WELL PLUGGING RECORD

Give All Information Completely
Make Required Affidavit
Mail or Deliver Report to:
Conservation Division
State Corporation Commission
800 Bittling Building
Wichita, Kansas

Rice County. Sec. 14 Twp. 19 Rge. (E) 6 (W)

Location as "NE/CNW%SW%" or footage from lines NW NE SE
Lease Owner Graham-Messman-Rinehart Drilling Company
Lease Name Green Well No. 1
Office Address 1005 E. Second Street, Wichita, Kansas
Character of Well (completed as Oil, Gas or Dry Hole) Oil Well
Date well completed July 8, 1953
Application for plugging filed October 20, 1953
Application for plugging approved October 20, 1953
Plugging commenced October 21, 1953
Plugging completed October 23, 1953
Reason for abandonment of well or producing formation Depleted

NORTH

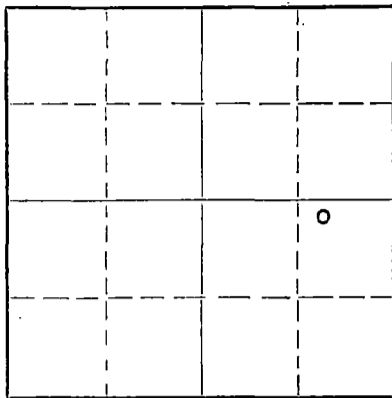

Locate well correctly on above
Section Plat

If a producing well is abandoned, date of last production September 13 19 53
Was permission obtained from the Conservation Division or its agents before plugging was commenced? yes

Name of Conservation Agent who supervised plugging of this well Mr. Warren H. Horner, R.R. #1, Lyons, Ks.
Producing formation Mississippi Depth to top 3378 Bottom Total Depth of Well 3396 Feet
Show depth and thickness of all water, oil and gas formations.

OIL, GAS OR WATER RECORDS

CASING RECORD

FORMATION	CONTENT	FROM	TO	SIZE	PUT IN	PULLED OUT
				8-5/8"	151'	none
				4-1/2"	3380'	2880'

Describe in detail the manner in which the well was plugged, indicating where the mud fluid was placed and the method or methods used in introducing it into the hole. If cement or other plugs were used, state the character of same and depth placed, from feet to feet for each plug set.

Filled up with sand to 3370 ft. and dumped 4 sx. cement. Filled up with mud to 250 ft. and put in 10 ft. rock bridge and dumped 20 sx. cement. Mud up to 40 ft. with 10 ft. rock bridge and dumped 10 sx. cement. Mud to surface.

(If additional description is necessary, use BACK of this sheet)

Name of Plugging Contractor Graham-Messman-Rinehart Oil Company
Address P. O. Box 1033, Wichita, Kansas

STATE OF Kansas COUNTY OF Sedgwick, ss.
J. A. Gilliland (employee of owner) of the above-described well, being first duly sworn on oath, says: That I have knowledge of the facts, statements, and matters herein contained and the log of the above-described well as filed and that the same are true and correct. So help me God.

(Signature) J. A. Gilliland
1005 E. Second St., Wichita, Kansas (Address)

SUBSCRIBED AND SWORN TO before me this 26th day of October, 1953

My commission expires December 1, 1956

Notary Public. [Signature]

PLUGGING
FILE SEC 14 T 19 R 6 W
BOOK PAGE 132 LINE 2

OCT 30 1953
CONSERVATION DIVISION
Wichita, Kansas
10-30-1953

Green #1

Location: NW NE SE, SEC. 14-19-6w,
Rice County, Kansas

Commenced: June 4, 1953

Operator: Graham-Messman-Rinehart Oil Co.
1005 E. Second Street
Wichita, Kansas

Completed: July 9, 1953

Elevation: 1620 K. B.

Contractor: Graham-Messman-Rinehart Oil Co.

Production: Oil Well

Casing Record: 8 5/8" @ 151' w/110 sx's Cem. 3 c.c.'s.
4 1/2" @ 3396' w/60 sx's Cem. 1 c.c.'s.

LOG

Sand & Clay	105
Sand & Shale	151
Shale & Shells	386
Shale & Lime	872
Shale & Lime	1094
Shale & Lime	1276
Shale & Lime	1414
Shale & Lime	1620
Shale & Lime	1965
Shale & Lime	2163
Shale & Lime	2198
Shale & Lime	2451
Shale & Lime	2558
Shale & Lime	2728
Shale & Lime	2800
Shale & Lime	2871
Shale & Lime	2977
Lime & Shale	3013
Lime	3051
Lime	3110
Lime	3141
Lime	3186
Lime	3249
Lime	3301
Lime	3342
Lime	3388
Mississippi	3388
T.D.	3404

TOPS:

Cherty Conglomerate	3326	(-1706)
Mississippi Chat	3378	(-1758)

The undersigned, Graham-Messman-Rinehart Oil Company, hereby certifies that the above log is a true and correct log of the formation encountered in drilling the above well as reflected by the Daily Drilling Reports.

Graham-Messman-Rinehart Oil Company

By J. A. Gilliland
J. A. Gilliland

Subscribed and sworn to before me
this 13th day of July 1953

Barbara J. Scott
Notary Public
My commission expires: Dec. 1, 1956

PLUGGING
FILE SEC 14-19-6w
BOOK PAGE 37 LINE 2

RECEIVED
CORPORATION COMMISSION
OCT 30 1953
CONSERVATION DIVISION
Wichita, Kansas