


STATE OF KANSAS
STATE CORPORATION COMMISSION

WELL PLUGGING RECORD

Give All Information Completely
Make Required Affidavit
Mail or Deliver Report to:
Conservation Division
State Corporation Commission
800 Bittling Building
Wichita, Kansas

Rice County. Sec. 23 Twp. 18 Rge. 10 ~~W~~ W (W)
Location as "NE/CNW%SW%" or footage from lines SW SW SW
Lease Owner Harms-Burt Drilling Company
Lease Name Salem Church Well No. 1
Office Address Box 184, Great Bend, Kansas
Character of Well (completed as Oil, Gas or Dry Hole) Dry Hole
Date well completed October 31 19 54
Application for plugging filed November 9 19 54
Application for plugging approved November 29 19 54
Plugging commenced November 27 19 54
Plugging completed December 3 19 54
Reason for abandonment of well or producing formation Dry Hole

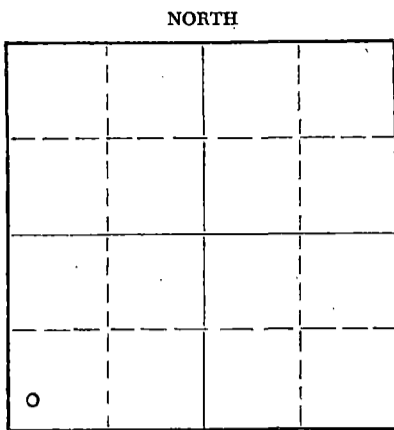

Locate well correctly on above
Section Plat

If a producing well is abandoned, date of last production _____ 19____
Was permission obtained from the Conservation Division or its agents before plugging was commenced? yes

Name of Conservation Agent who supervised plugging of this well Ruel Durkee
Producing formation _____ Depth to top _____ Bottom _____ Total Depth of Well _____ Feet
Show depth and thickness of all water, oil and gas formations.

OIL, GAS OR WATER RECORDS

CASING RECORD

FORMATION	CONTENT	FROM	TO	SIZE	PUT IN	PULLED OUT
Surface		0	162	8 5/8"	162	0
Long string Arbuckle		0	3270	5 1/2 "	3270	2701.49

Describe in detail the manner in which the well was plugged, indicating where the mud fluid was placed and the method or methods used in introducing it into the hole. If cement or other plugs were used, state the character of same and depth placed, from _____ feet to _____ feet for each plug set.

Plugged back 3278 to 3260 sand
3260 to 3218 cement 6 sacks
3218 to 174 mud
hole bridged @ 174
174 to 164 rock bridge
164 to 160 paper breaker
160 to 70 cement 30 sacks
70 to 15 mud - rock bridge
15' to bottom of cellar cement 5 sacks

(If additional description is necessary, use BACK of this sheet)

Name of Plugging Contractor R & D Casing Pulling Company Permit No. 236
Address Ellinwood, Kansas

STATE OF Kansas, COUNTY OF Barton, ss.
Allan Harms (employee of owner) or (owner or operator) of the above-described well, being first duly sworn on oath, says: That I have knowledge of the facts, statements, and matters herein contained and the log of the above-described well as filed and that the same are true and correct. So help me God.

(Signature) Allan Harms
Box 184, Great Bend, Kans.
(Address)

SUBSCRIBED AND SWORN TO before me this 9th day of December, 1954

My commission expires Jan. 20, 1958

Mary E Van Pelt
Mary E. Van Pelt Notary Public.

PLUGGING
FILE SEC 23 TWP 18 RGE 10
BOOK PAGE 10 LINE 19

STATE CORPORATION COMMISSION
DEC 10 1954
CONSERVATION DIVISION
Wichita, Kansas

19-10-1954

DRILLER'S LOG

Company: Harms-Burt Drilling Co.

SW SW SW Sec. 23-18-10W
Rice County, Kansas

Farm: Salem Church No. 1

Commenced: October 3, 1954

Completed: October 31, 1954

Elevation: 1752 DF

0- 110	Soil, clay with gravel streaks	1930-2030	Lime & shale
110- 162	Shale & shells	2030-2330	Shale & lime
162- 260	Shale & shells	2330-2661	Lime & shale
260- 438	Red bed	2661-2724	Shale & lime
438- 461	Anhydrite	2724-2812	Lime
461- 565	Red bed & shale	2812-2879	Shale & lime
565-1180	Shale & shells	2879-2915	Lime & shale
1180-1270	Lime with shale breaks	2915-3195	Lime
1270-1385	Shale & shells	3195-3226	Shale & lime
1385-1450	Shale & lime	3226-3269	Conglomerate
1450-1657	Lime & shale	3269-3272	Arbuckle lime & chert
1657-1790	Shale & shells	3272	Rotary Total Depth
1790-1930	Shale & lime		

Set 162' of 8 5/8" surface pipe, cemented with 175 sacks common cement and 3 sacks calcium chloride.

Tops: Arbuckle 3269'

Set 3270' of 5 1/2" casing, cemented with 50 sacks common cement.

Cable tools:

3272-3276 1/2 Dolomite
3276 1/2 T.D.

Dry, plugged, and abandoned.

AFFIDAVIT:

State of Kansas) SS.
County of Barton)

I, Allan Harms of the Harms-Burt Drilling Company, being first duly sworn on oath state: That I have knowledge of the facts, statements, and matters herein contained, and that the same are true and correct.

Signed: *Allan Harms*

Subscribed and sworn to before me this 9th day of December, 1954.

My commission expires: 1-20-58

Mary E. Van Pelt
Notary Public Mary E. Van Pelt

