


STATE OF KANSAS
STATE CORPORATION COMMISSION

Form CP-4

WELL PLUGGING RECORD

Give All Information Completely
Make Required Affidavit
Mail or Deliver Report to:
Conservation Division
State Corporation Commission
212 No. Market
Wichita, Kansas

Rice County, Sec. 20 Twp. 18S Rge. 10W (E) (W)
Location as "NE/CNW/SW" or footage from lines NW SW SE

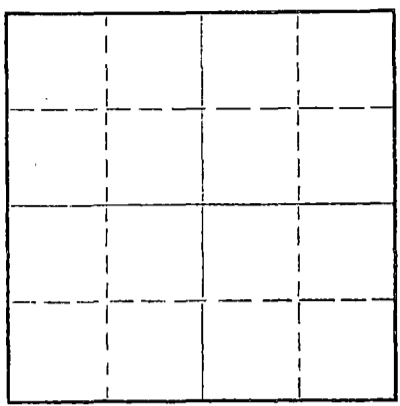

Lease Owner Allison & Black
Lease Name Manke Well No. 4
Office Address 1415 Wichita Plaza - Wichita, Kansas
Character of Well (completed as Oil, Gas or Dry Hole) dry
Date well completed 3-13 19 68
Application for plugging filed 3-13 19 68
Application for plugging approved 3-13 19 68
Plugging commenced 1:30 3-13 19 68
Plugging completed 8:00 PM - 3-13 19 68
Reason for abandonment of well or producing formation dry

If a producing well is abandoned, date of last production 19
Was permission obtained from the Conservation Division or its agents before plugging was commenced? Yes

Name of Conservation Agent who supervised plugging of this well Gilbert Towman
Producing formation none Depth to top Bottom Total Depth of Well 3275 Feet
Show depth and thickness of all water, oil and gas formations.

OIL, GAS OR WATER RECORDS

CASING RECORD

FORMATION	CONTENT	FROM	TO	SIZE	PUT IN	PULLED OUT
Soil & Shale		0	235'	8 5/8	235	0

Describe in detail the manner in which the well was plugged, indicating where the mud fluid was placed and the method or methods used in introducing it into the hole. If cement or other plugs used, state the character of same and depth placed, from feet to feet for each plug set.

Plugged hole - circulated hole - 25 sx @ 500'
25 sx at 225' 10 sx at 40'
and 2 sx in rat hole.
Plugged by Gilbert Towman & Globe Truck

RECEIVED
STATE CORPORATION COMMISSION
MAR 18 1968
CONSERVATION DIVISION
Wichita, Kansas 3-18-1968

(If additional description is necessary, use BACK of this sheet)
Name of Plugging Contractor B & B Drilling, Inc.
Address 548 Petroleum Building - Wichita, Kansas

STATE OF Kansas, COUNTY OF Sedgwick, ss.
Bill Lahar (employee of owner) or (owner or operator) of the above-described well, being first duly sworn on oath, says: That I have knowledge of the facts, statements, and matters herein contained and the log of the above-described well as filed and that the same are true and correct. So help me God.

(Signature) Bill Lahar
548 Petroleum Building - Wichita, Kansas
(Address)

SUBSCRIBED AND SWORN TO before me this 15th day of March, 19 68

May 31, 1970

My commission expires Notary Public.

B & B DRILLING, INC.

548 Petroleum Building
Wichita, Kansas 67202

March 15, 1968

DRILLERS LOG

Re: Manke #4
NW SW SE Sec. 20-18S-10W
Rice County, Kansas

COMPANY: Allison & Black
CONTRACTOR: B & B Drilling, Inc.
TOTAL DEPTH: 3275'
COMMENCED: 3-6-68
COMPLETED: 3-13-68

0	174	Soil & Clay
174	235	Sand & Shale
235	511	Shale - Red Bed
511	521	Anhydrite
521	990	Shale
990	1475	Shale & Lime
1475	1735	Shale & Lime
1735	1920	Lime & Shale
1920	2355	Shale & Lime
2355	2600	Shale & Lime
2600	2724	Shale & Lime
2724	2839	Lime
2839	2955	Lime & Shale
2955	3037	Lime & Shale
3037	3120	Lime
3120	3200	Lime
3200	3227	Lime & Shale DST # 1
3227	3262	Lime & Shale DST # 2
3262	3266	Lime DST # 3 & 4
3266	3270	Lime
3270	3275	Lime DST # 5
3275		Total Depth D & A

We certify the above and foregoing to be true and correct copy of the log on the #4 Manke, located in Rice County, Kansas

Bill Laker President

Olma A. Meiser Notary Public

Subscribed and sworn to before me this 15th day of March, 1968

My commission expires May 31, 1970