


STATE OF KANSAS
STATE CORPORATION COMMISSION

WELL PLUGGING RECORD

Give All Information Completely
Make Required Affidavit
Mail or Deliver Report to:
Conservation Division
State Corporation Commission
800 Bitting Building
Wichita, Kansas

Rice County, Sec. 20 Twp. 18S Rge. (E) 10 (W)
Location as "NE/CNW/SW" or footage from lines C SW NE SW
Lease Owner Donald T. Ingling and Albert R. Jones
Lease Name J. Heiken Well No. 1
Office Address Wichita, Kansas
Character of Well (completed as Oil, Gas or Dry Hole) Dry Hole
Date well completed January 24, 1953
Application for plugging filed January 24, 1953
Application for plugging approved January 24, 1953
Plugging commenced January 24, 1953
Plugging completed January 24, 1953
Reason for abandonment of well or producing formation Dry

NORTH

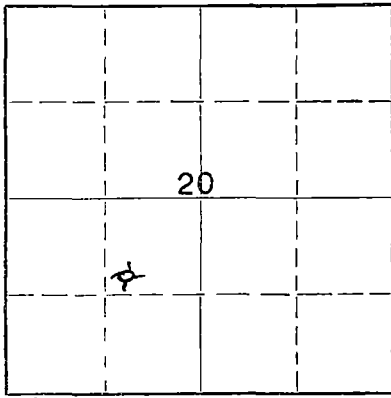

Locate well correctly on above
Section Flat

If a producing well is abandoned, date of last production None 19
Was permission obtained from the Conservation Division or its agents before plugging was commenced? Yes

Name of Conservation Agent who supervised plugging of this well Mr. Ruel Durkee, McPherson, Kansas
Producing formation _____ Depth to top _____ Bottom _____ Total Depth of Well 3288 Feet
Show depth and thickness of all water, oil and gas formations.

OIL, GAS OR WATER RECORDS

CASING RECORD

FORMATION	CONTENT	FROM	TO	SIZE	PUT IN	PULLED OUT
				8 5/8"	265'	None

Describe in detail the manner in which the well was plugged, indicating where the mud fluid was placed and the method or methods used in introducing it into the hole. If cement or other plugs were used, state the character of same and depth placed, from _____ feet to _____ feet for each plug set.

Circulated with heavy mud and laid down one-half drill pipe - circulated with heavy mud and laid down balance of drill pipe - put bottom plug at 265 feet with solid bridge - put 15 sacks of cement on bottom plug through drill pipe - put bridge at 30 feet and capped with 5 sacks of cement.

(If additional description is necessary, use BACK of this sheet)

Name of Plugging Contractor D. T. Ingling
Address 611 Orpheum Building, Wichita 2, Kansas


STATE OF KANSAS, COUNTY OF SEDGWICK, ss.
D. T. Ingling (employee of owner) or (owner or operator) of the above-described well, being first duly sworn on oath, says: That I have knowledge of the facts, statements, and matters herein contained and the log of the above-described well as filed and that the same are true and correct. So help me God.

(Signature) [Signature]
611 Orpheum Bldg., Wichita 2, Kansas
(Address)

SUBSCRIBED AND SWORN to before me this 27th day of January, 19 53

[Signature]
Notary Public.

My commission expires February 27, 1956

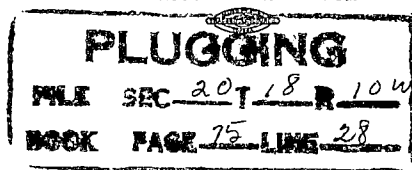

RECEIVED
STATE CORPORATION COMMISSION
JAN 1 1953
1-31-1953
CONSERVATION DIVISION
Wichita, Kansas

WELL LOG - - J. HEIKEN #1

Donald T. Ingling and Albert R. Jones, Lease Owners

Donald T. Ingling, Operator

Section 20-18S-10W

Commenced: 1-7-53 (staked and dug cellar
Completed: 1-24-53 on 12-30-52)

Location: C SW NE SW

County: Rice, Kansas

Total Depth: 3288'

Production: Dry

Casing: 8 5/8" - 265'

Elevation: 1747 DF

Figures below indicate bottom formation

40	Surface clay	2345	Lime and shale
100	Surface clay	2400	Lime and shale
115	Sand	2460	Lime and shale
240	Shale	2520	Lime and shale
259	Shale	2565	Lime and shale
265	Shale and shells	2610	Lime
280	Shale, shells and red rock	2665	Lime and shale
490	Red rock	2710	Lime
515	Lime, Anhydrite	2740	Lime
875	Shale, shells and red rock	2784	Lime
1100	Red rock, shale and shells	2815	Lime
1240	Shale and lime	2865	Lime and shale
1265	Lime	2900	Shale and lime
1350	Lime	2920	Shale
1470	Lime and shale	2965	Lime
1555	Lime and shale	3000	Lime
1585	Lime	3030	Lime
1625	Sandy lime	3075	Lime
1660	Lime	3105	Lime
1670	Lime	3140	Lime
1735	Lime and shale	3175	Lime
1770	Lime and shale	3210	Lime
1775	Lime	3220	Lime
1810	Lime	3250	Shale
1886	Lime and shale	3267	Conglomerate
1945	Lime and shale	3280	Arbuckle
2045	Lime and shale	3288	Arbuckle
2145	Lime and shale	3288	Total Depth
2255	Lime and shale		

PLUGGING
 FILE SEC 20 T 18 R 10W
 BOOK PAGE 75 LINE 28

I certify this is a true and correct log of the above mentioned well

STATE OF KANSAS)
) SS
 COUNTY OF SEDGWICK)

D. T. Ingling
 D. T. Ingling

Subscribed and sworn to before me, a Notary Public in said County and State

M. E. Black
 Notary Public

My commission expires February 27, 1956