


WELL PLUGGING RECORD

Give All Information Completely
on Required Affidavit
File or Deliver Report to:
Conservation Division
State Corporation Commission
211 No. Broadway
Wichita, Kansas

NORTH

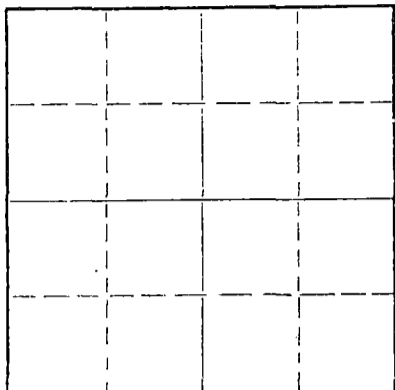

Locate well correctly on above
Section Plat

Rice County, Sec. 27 Twp. 19S Rge. 8W (E) (W)
Location as "NE/CNW/SW" or footage from lines NE NE NE
Lease Owner Inger Oil Company
Lease Name Dressler Well No. 1
Office Address 1020 Central Building, Wichita, Kansas
Character of Well (completed as Oil, Gas or Dry Hole) Dry Hole
Date well completed 11-21-63 19
Application for plugging filed 11-21-63 19
Application for plugging approved 11-21-63 19
Plugging commenced 11-21-63 19
Plugging completed 11-21-63 19
Reason for abandonment of well or producing formation Dry Hole

If a producing well is abandoned, date of last production 19
Was permission obtained from the Conservation Division or its agents before plugging was commenced? yes (Holyrood, KS.) Done For

Name of Conservation Agent who supervised plugging of this well Gilbert Toman, Russell, Kansas (DONALD TRAVN)
Producing formation Depth to top Bottom Total Depth of Well 3500 Feet
Show depth and thickness of all water, oil and gas formations.

OIL, GAS OR WATER RECORDS

CASING RECORD

FORMATION	CONTENT	FROM	TO	SIZE	PUT IN	PULLED OUT
				8 5/8"	207'	none

Describe in detail the manner in which the well was plugged, indicating where the mud fluid was placed and the method or methods used in introducing it into the hole. If cement or other plugs were used, state the character of same and depth placed, from feet to feet for each plug set.

Mud to 200' Plug & 1/2 sack hulls & 25 sacks cement
Mud to 40' Plug & 1/4 sack hulls & 10 sacks cement

RECEIVED
STATE CORPORATION COMMISSION

NOV 26 1963

CONSERVATION DIVISION
Wichita, Kansas

11-26-1963

(If additional description is necessary, use BACK of this sheet)

Name of Plugging Contractor Leben Drilling, Inc.
Address P. O. Box 486, Great Bend, Kansas

STATE OF KANSAS, COUNTY OF BARTON, ss.
Leslie Kite

(employee of owner) or (owner or operator) of the above-described well, being first duly sworn on oath, says: That I have knowledge of the facts, statements, and matters herein contained and the log of the above-described well as filed and that the same are true and correct. So help me God.

(Signature) Leslie Kite
P. O. Box 486, Great Bend, Kansas
(Address)

SUBSCRIBED AND SWORN TO before me this 23rd day of November, 19 63

My commission expires April 1, 1967 Ulanda Nichols Notary Public.



DRILLER'S LOG

COMPANY: Inger Oil Company
 CONTRACTOR: LEBEN DRILLING, INC.
 FARM: DRESSLER #1
 LOCATION: NE NE NE Sec. 27-19S-8W
 RICE COUNTY, KANSAS
 COMMENCED: 11-14-63
 COMPLETED: 11-21-63

0	75	Clay
75	207	Shale
207	290	Redbed
290	310	Anhydrite
310	750	Redbed & Shale
750	1090	Shale & Lime
1090	1755	Lime
1755	2310	Lime & Shale
2310	2460	Shale & Lime
2460	2778	Lime & Shale
2778	2826	Sand
2826	3275	Lime
3275	3345	Shale
3345	3350	Sand
3350	3357	Shale & Sand
3357	3427	Viola Lime
3427	3430	Simpson Sand
3430	3445	Shale
3445	3500	Arbuckle
	<u>3500</u>	<u>Rotary Total Depth - D & A</u>

RECEIVED
 STATE CORPORATION COMMISSION
 NOV 26 1963
 CONSERVATION DIVISION
 Wichita, Kansas

Set 8 5/8" used surface casing @ 207' with landing joint Cemented with 175 sacks Posmix HA5.

I, Leslie Kite, do hereby certify that the above and foregoing is a true and correct copy of the log of the Dressler #1, located Northeast of Northeast of Northeast (NE NE NE) of Section 27, Township 19 South, 8 West, Rice County, Kansas, as reflected by the files of Leben Drilling, Inc.

Leslie Kite
 Leslie Kite

STATE OF KANSAS)
) SS
 COUNTY OF BARTON)

Subscribed and sworn to before me, a Notary Public, in and for Barton County, Kansas, this 23rd day of November, 1963.

Donald E. Hunt
 Donald E. Hunt, Notary Public

My Commission Expires:
 August 17, 1965