


STATE OF KANSAS
STATE CORPORATION COMMISSION
CONSERVATION DIVISION
P. O. BOX 17027
WICHITA, KANSAS 67217

15.157.50003.00.01
Replug!
RECEIVED
STATE CORPORATION COMMISSION
NOV 25 1974
CONSERVATION DIVISION
Wichita, Kansas
FORM CP-4
11-25-1974
WELL PLUGGING RECORD

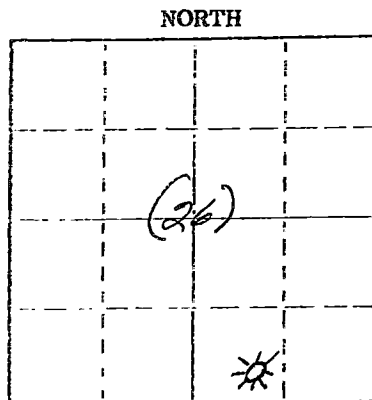

Locate well correctly on above
Section Plat

Rice County. Sec. 26 Twp. 19S Rge. (E) 8W (W)
Location as "NE/CNW&SW&" or footage from lines SE SW SE
Lease Owner Northern Natural Gas Company
Lease Name Imperial Smith Well No. 1
Office Address P.O. Box 88 - Lyons, Kansas 67554
Character of Well (completed as Oil, Gas or Dry Hole)
Date well completed 12-29-64 19
Application for plugging filed 8-01-74 19
Application for plugging approved 8-05-74 19
Plugging commenced 11-18-74 19
Plugging completed 11-21-74 19
Reason for abandonment of well or producing formation

If a producing well is abandoned, date of last production 19
Was permission obtained from the Conservation Division or its agents before plugging was commenced?

Name of Conservation Agent who supervised plugging of this well Gib Toman - Holyrood, Kansas
Producing formation Depth to top Bottom Total Depth of Well Feet
Show depth and thickness of all water, oil and gas formations.

OIL, GAS OR WATER RECORDS

CASING RECORD

FORMATION	CONTENT	FROM	TO	SIZE	PUT IN	PULLED OUT
		Surface	243	8-5/8"	-	none

Describe in detail the manner in which the well was plugged, indicating where the mud fluid was placed and the method or methods used in introducing it into the hole. If cement or other plugs were used, state the character of same and depth placed, from feet to feet for each plug set.

TD 3590 - Halliburton mixed & spotted 200 sacks common cement
plus 18% salt through drill pipe from 3590 back to 2835.
Spotted 35 sacks common cement from 240 back to 140.
Spotted 15 sacks common cement from 40 back to surface.

NOTE: Original plug depth was 3490, drilled to 3590 with intent to
make this well into an observation well but decided to replug
the well.

(If additional description is necessary, use BACK of this sheet)

Name of Plugging Contractor Graves Drilling Co., Inc.
Address 505 Union Center - Wichita, Kansas 67202

STATE OF Kansas COUNTY OF Rice ss.
F. L. Holliger (employee of owner) or (owner or operator) of the above-described
well, being first duly sworn on oath, says: That I have knowledge of the facts, statements, and matters herein contained and the log of the
above-described well as filed and that the same are true and correct. So help me God.

(Signature) F. L. Holliger Project Manager
P.O. Box 88 - Lyons, Kansas 67554

SUBSCRIBED AND SWORN TO before me this 22nd day of November, 1974

My commission expires 7-16-78

Notary Public.

ROBERT E. CULLISON
STATE NOTARY PUBLIC
My Commission Expires
7-16-78
Rice County, Kansas

STATE OF KANSAS
STATE CORPORATION COMMISSION

Give All Information Completely
Make Required Affidavit
Mail or Deliver Report to:
Conservation Division
State Corporation Commission
211 No. Broadway
Wichita, Kansas

WELL PLUGGING RECORD

Rice

County, Sec. 26 Twp. 19S Rge. 8W (E) (W)

Location as "NE/CNW/SW" or footage from lines SE SW SE

Lease Owner Imperial Oil Company

Lease Name Smith

Well No. 1

Office Address 780 Fourth Nat'l Bldg., Wichita 2, Kansas

Character of Well (completed as Oil, Gas or Dry Hole) Dry hole

Date well completed 12-29-64

Application for plugging filed 12-29-64

Application for plugging approved 12-29-64

Plugging commenced 12-29-64

Plugging completed 12-29-64

Reason for abandonment of well or producing formation No commercial quantities of oil found.

If a producing well is abandoned, date of last production

Was permission obtained from the Conservation Division or its agents before plugging was commenced? Yes

Name of Conservation Agent who supervised plugging of this well Gilbert Toman, Holyrood, Kansas

Producing formation Depth to top Bottom Total Depth of Well 3490 Feet

Show depth and thickness of all water, oil and gas formations.

OIL, GAS OR WATER RECORDS

CASING RECORD

FORMATION	CONTENT	FROM	TO	SIZE	PUT IN	PULLED OUT
	Surface casing	-	-	8-5/8"	243	Not pulled

Describe in detail the manner in which the well was plugged, indicating where the mud fluid was placed and the method or methods used in introducing it into the hole. If cement or other plugs were used, state the character of same and depth placed, from feet to feet for each plug set.

Set first plug at 230 ft. with 20 sacks
Set second plug at 40 ft. with 10 sacks

RECEIVED
STATE CORPORATION COMMISSION

NOV 25 1974

CONSERVATION DIVISION
Wichita, Kansas

11-25-1974

(If additional description is necessary, use BACK of this sheet)

Name of Plugging Contractor Imperial Oil of Kansas, Inc.

Address P.O. Box 784, Great Bend, Kansas

STATE OF KANSAS, COUNTY OF SEDGWICK, ss.
William A. Sladek

(employee of owner) of the above-described well, being first duly sworn on oath, says: That I have knowledge of the facts, statements, and matters herein contained and the log of the above-described well as filed and that the same are true and correct. So help me God.

(Signature)

780 Fourth Nat'l Building, Wichita, Ks,
(Address)

SUBSCRIBED AND SWORN TO before me this 12th day of January, 1965

My commission expires July 5, 1966.

Bette J. Silcott
Bette J. Silcott

Notary Public.

DRILLER'S LOG

15. 159. 30003.00.01

Imperial Oil Company
780 Fourth National Building
Wichita, Kansas

Smith No. 1
SE SW SE Sec. 26-19S-8W
Rice County, Kansas

Total Depth: 3490

Elevation: 1728 KB

Commenced: 12-21-64

Completed: 12-29-64
D & A

Contractor: Imperial Oil of Kansas, Inc.
Rig #2

Casing Record: Set 8-5/8" casing at 243 ft. with 165 sacks cement.

Figures indicate bottom of formations:

Tops:

Shale-sand 242
Shale-red bed 390
Shale-shells 1030
Salt-shale 1368
Lime-shale 1665
Shale-lime 1830
Shale 2160
Lime & shale 2900
Lime 3322
Lime-shale 3390
Lime & chert 3410
Lime & chert "hard" 3417
Lime & shale 3487
Lime 3490

Top of Anhydrite 270 (+1458)
Heebner 2703 (- 975)
Brown Lime 2839 (-1111)
Lansing 2875 (-1147)
Base Kansas City 3187 (-1459)
Kinderhook 3223 (-1495)
Viola 3350 (-1622)
Simpson 3385 (-1657)

Arbuckle RECEIVED No log top
STATE CORPORATION COMMISSION 448 - (1720) SAMPLE TOP

NOV 25 1964

CONSERVATION DIVISION
Wichita, Kansas

RECEIVED
STATE CORPORATION COMMISSION

JAN 13 1965

CONSERVATION DIVISION
Wichita, Kansas

RTD 3490

We hereby certify this to be a correct and accurate log of the above described well, as shown on the daily drilling reports.

IMPERIAL OIL COMPANY

By _____
Don R. Pate

Subscribed and sworn to before me this 12th day of January, 1965.

IMPERIAL OIL OF KANSAS #1 SMITH

26-19-8W
SE SW SE

Notary Public

My

Contr. CO TOOLS _____ RICE _____ County

E 1728 KB Comm. 12/21/64 Comp. 1/7/65 IP D & A (ARB)

LOG Tops	Depth	Datum
ANH	270	+1458
HEEB	2703	-975
BR LM	2839	-1111
LANS	2875	-1147
B KC	3187	-1459
KIND	3223	-1495
VID	3350	-1622
SIMP	3385	-1657
*ARB	3448	-1720
RTD	3490	-1762


Casing 8" 243/165 sx:
DST 3378-90/2 HRS, 75' WM, BHP
918-849#/20", FP 19-38#:
DST 3410-90/30", 2460' SW, BHP
1153-1153#/20", FP 888-1153#:

3448
3385
065

3448
3385
065

3

LYONS T/S

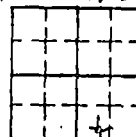

GEOL: DON PATE:

* SMP TOP
INDEPENDENT OIL & GAS SERVICE
WICHITA, KANSAS

15.159.30003.00.01

TYPE

NOTICE OF INTENTION TO DRILL

C-1

TO BE FILED WITH THE STATE CORPORATION COMMISSION
PRIOR TO COMMENCEMENT OF WELL

API Number

(For office use only)

Starting Date

8-8-74

County

Rice

Sec

26

Twp

19

S

Rge

8W

E

W

Spot Location

SE SW SE

Nearest Lease Line

ft.

Lease Name

Smith

Well No.

1

Est. Total Depth

3490

ft.

1. Operator Northern Natural Gas CompanyAddress P.O. Box 88 - Lyons, Kansas 675542. Contractor Graves Drilling Co., Inc.Address 505 Union Center - Wichita, Ks. 672023. Type of Equipment: Rotary Yes Cable Tool

4. Well to be Drilled for: Oil Gas

Disposal Input Other Re-enter5. Depth of Deepest Fresh Water within 1 mile 67 ft.6. Depth of Municipal Water Well within 3 miles 68 ft.7. Depth to Protect all Fresh Water 200 ft.8. Amount of Surface Casing to be set 243 ft.9. Alternate No. 1 X No. 2

REMARKS:

OPERATOR STATES THAT HE WILL COMPLY WITH K. S. A. 55-128

Imperial Oil Co.

Comm. 12-21-64 - Comp. 12-29-64

Plug date: 12-29-64

Signature of Operator

Project Manager

34-7312-S-21-90



1-73-20M

MAILED

AUG 05 1974

CONSERVATION DIVISION
 WICHITA, KANSAS

RECEIVED
 STATE CORPORATION COMMISSION

NOV 25 1974

CONSERVATION DIVISION
 Wichita, Kansas