


Give All Information Completely  
Make Required Affidavit  
Mail or Deliver Report to:  
Conservation Division  
State Corporation Commission  
212 No. Market  
Wichita, Kansas

WELL PLUGGING RECORD

NORTH

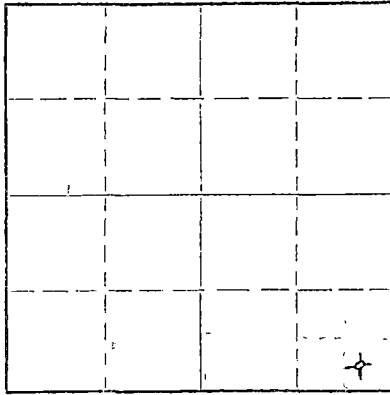

Locate well correctly on above  
Section Plat

Rice County. Sec. 18 Twp. 19 Rge. 8 (E) W (W)

Location as "NE/CNW/SW" or footage from lines 175' W of SE SE SE

Lease Owner Don Fox

Lease Name REED Well No. 1

Office Address Chase, Kansas

Character of Well (completed as Oil, Gas or Dry Hole) Dry Hole

Date well completed March 5, 1970 19

Application for plugging filed " " 19 70

Application for plugging approved. " " 19 70

Plugging commenced March 5, 19 70

Plugging completed " " 19 70

Reason for abandonment of well or producing formation

If a producing well is abandoned, date of last production 19

Was permission obtained from the Conservation Division or its agents before plugging was commenced? yes

Name of Conservation Agent who supervised plugging of this well Gilbert Toman

Producing formation Depth to top Bottom Total Depth of Well 3385 Feet

Show depth and thickness of all water, oil and gas formations.

OIL, GAS OR WATER RECORDS

CASING RECORD

FORMATION	CONTENT	FROM	TO	SIZE	PUT IN	PULLED OUT

Describe in detail the manner in which the well was plugged, indicating where the mud fluid was placed and the method or methods used in introducing it into the hole. If cement or other plugs were used, state the character of same and depth placed, from feet to feet for each plug set.

Hole full of heavymud to 200' - Set plug  
1/4 sk. hulls and 25 sacks cement  
come up hole to 40'  
1/4 sk. hulls - plug-good bridge and 10 sacks cement.  
2 sacks in rat hole.

RECEIVED  
STATE CORPORATION COMMISSION  
MAR 11 1970  
CONSERVATION DIVISION  
Wichita, Kansas

3-11-1970

(If additional description is necessary, use BACK of this sheet)

Name of Plugging Contractor

Address

STATE OF Kansas, COUNTY OF Barton, ss.

Larry Curtis (employee of owner) or (owner/operator) of the above-described

well, being first duly sworn on oath, says: That I have knowledge of the facts, statements, and matters herein contained and the log of the above-described well as filed and that the same are true and correct. So help me God.

(Signature) Larry Curtis

Box 823 - Great Bend, Ks. (Address)

SUBSCRIBED AND SWORN TO before me this 5th day of March, 1970

My commission expires April 11, 1970 Notary Public.

15.159.20292.00.00

DRILLERS' WELL LOG

DATE COMMENCED: February 25, 1970  
 DATE COMPLETED: March 5th, 1970

Don Fox  
 REED #1  
 175' W of SE SE SE  
 Sec. 18-T19S-R8W  
 Rice County, Kansas

0	-	25'	Clay
25	-	85'	Sand & Shale
85	-	291'	Shale & Red Bed
291	-	297'	Anhydrite
307	-	1240'	Shale & Shells
1140	-	1515'	Shale & Linc
1515	-	2200'	Linc & Shale
2200	-	2350'	Shale & Shells
2350	-	2660'	Linc & Shale
2660	-	2717'	Shale & Linc
2717	-	2720'	Shale
2720	-	2730'	Linc & Shale
2730	-	2747'	Linc
2747	-	2848'	Shale
2848	-	2881'	Linc & Shale
2881	-	3171'	Linc
3171	-	3188'	Conglomerate
3188	-	3200'	Linc
3200	-	3207'	Sand
3207	-	3312'	Conglomerate
3312	-	3368'	Chert
3368	-	3374'	Sand
3374	-	3385'	Shale
3385	-		RED

ELEVATION: 1765 K.B.

FORMATION DATA

Anhydrite	291
Heebner	2717
Dr. Linc	2848
Lansing	3881
Base K.C.	3171
Kinderhook Linc	3188
Kinderhook Sand	3200
Elola	3312
Sinpson Sd.	3368
RED	3385

SURFACE CASING: Set  
 new 20/ 8-5/8" at 209'  
 with 175 sacks cement.

A F F I D A V I T

STATE OF KANSAS  
 COUNTY OF BARTON ) ss.

Larry Curtis, of lawful age, does swear and state that the facts and statements herein contained are true and correct to the best of his knowledge.

Larry Curtis

Subscribed and sworn to before me this 0th day of March 1970.

My Comm. expires:  
4-11-70

Maureen M. Hague  
 Notary Public