


WELL PLUGGING RECORD

Give All Information Completely  
Make Required Affidavit  
Mail or Deliver Report to:  
Conservation Division  
State Corporation Commission  
211 No. Broadway  
Wichita, Kansas

Rice County. Sec. 18 Twp. 19s Rge. 8W (E) (W)  
Location as "NE/CNW $\frac{1}{2}$ SW $\frac{1}{2}$ " or footage from lines C-NW-NE  
Lease Owner Aladdin Petroleum Corporation  
Lease Name Poland Well No. 1  
Office Address 809 Petroleum Building, Wichita, Kansas 67202  
Character of Well (completed as Oil, Gas or Dry Hole) Dry Hole  
Date well completed 12-23-64 19  
Application for plugging filed 12-23-64 19  
Application for plugging approved 12-23-64 19  
Plugging commenced 12-23-64 19  
Plugging completed 12-23-64 19  
Reason for abandonment of well or producing formation Dry Hole

NORTH

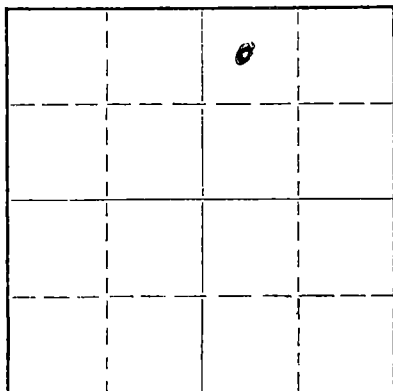

Locate well correctly on above  
Section Plat

If a producing well is abandoned, date of last production \_\_\_\_\_ 19\_\_\_\_  
Was permission obtained from the Conservation Division or its agents before plugging was commenced? Yes

Name of Conservation Agent who supervised plugging of this well Gilbert J. Toman  
Producing formation \_\_\_\_\_ Depth to top \_\_\_\_\_ Bottom \_\_\_\_\_ Total Depth of Well \_\_\_\_\_ Feet  
Show depth and thickness of all water, oil and gas formations.

OIL, GAS OR WATER RECORDS

CASING RECORD

FORMATION	CONTENT	FROM	TO	SIZE	PUT IN	PULLED OUT

Describe in detail the manner in which the well was plugged, indicating where the mud fluid was placed and the method or methods used in introducing it into the hole. If cement or other plugs were used, state the character of same and depth placed, from 3482 feet to 200 feet for each plug set.

Mud from total depth to 200 ft. -- 1/4 sk. hulls, plug and 25 sks. cement -- Mud to 40' ft. plug and 1/2 sk. hulls and 10 sks. -- Cement to bottom of cellar and 2 sks. in rathole.

RECEIVED  
STATE CORPORATION COMMISSION

JAN 4 1965

1-4-1965  
CONSERVATION DIVISION  
Wichita, Kansas

(If additional description is necessary, use BACK of this sheet)

Name of Plugging Contractor German Drilling Company  
Address 502 Petroleum Building, Wichita, Kansas 67202

STATE OF Kansas, COUNTY OF Sedgwick, ss.  
Harvey F. German (employee of owner) or (owner or operator) of the above-described well, being first duly sworn on oath, says: That I have knowledge of the facts, statements, and matters herein contained and the log of the above-described well as filed and that the same are true and correct. So help me God.

(Signature) Harvey F. German  
502 Petroleum Building, Wichita, Kansas  
(Address)

SUBSCRIBED AND SWORN TO before me this 24th day of December 19 64

My commission expires February 28th, 1968.

Geneva M. German  
Notary Public.

WELL LOG - Poland #1

OPERATOR: Aladdin Petroleum Corporation  
 809 Petroleum Building  
 Wichita, Kansas 67202

LOCATION: C-NW-NE  
 18-19s-8w  
 Rice County  
 Kansas

CONTRACTOR: German Drilling Company  
 502 Petroleum Building  
 Wichita, Kansas 67202

Farm: Poland -  
 Date Commenced: 12-15-64 -  
 Date Completed: 12-23-64 -

Well No. 1  
 Rotary

RECEIVED  
 STATE CORPORATION COMMISSION

JAN 4 1965

CONSERVATION DIVISION  
 Wichita, Kansas

From	To	Formation
0	5	Clay
5	140	Shale and shells
140	212	Shale and lime
212	650	Shale-Red Bed
650	1175	Shale and shells
1175	1440	Broken lime and shale
1440	1705	Lime and shale
1705	2080	Lime and shale
2080	2345	Shale and lime
2345	2495	Lime and shale
2495	2595	Lime and shale
2595	2665	Lime
2665	2780	Lime and shale
2780	2880	Lime and shale
2880	2900	Lime-Kansas City
2900	2936	Lime
2936	3035	Lime
3035	3132	Lime
3132	3206	Lime
3206	3256	Shale and sand
3256	3313	Shale-Maq.
3313	3356	Lime-Viola
3356	3404	Lime
3404	3430	Shale and lime
3430	3477	Lime-Arbuckle
3477	3482	Lime and chert
3482		Total depth

I hereby certify that the foregoing is a true and correct copy of the Well Log for the Poland #1, drilled for Aladdin Petroleum Corporation, and completed December 23rd, 1964.

GERMAN DRILLING COMPANY

Surface: 209 8 5/8  
 Production: None

*Harvey F. German*  
 Harvey F. German-Owner

STATE OF KANSAS )  
 ) ss.  
 COUNTY OF SEDGWICK )

Subscribed and sworn to, before the undersigned a Notary Public, in and for County and State aforesaid this twenty-fourth day of December, 1964.

*Geneva M. German*  
 Geneva M. German-Notary Public

My commission expires February 28th, 1968.