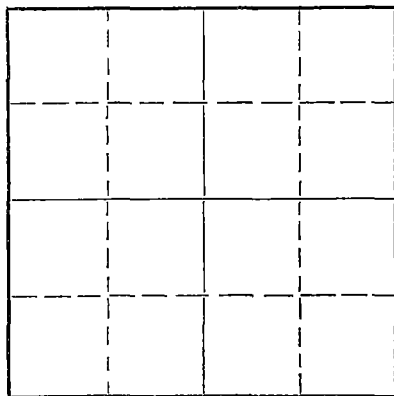


STATE OF KANSAS
STATE CORPORATION COMMISSION

Give All Information Completely
Make Required Affidavit
Mail or Deliver Report to:
Conservation Division
State Corporation Commission
30 Biting Building
Wichita, Kansas

WELL PLUGGING RECORD

NORTH

Locate well correctly on above
Section Plat

Rice County. Sec. 15 Twp. 19 Rge. 8 (E) (W)
Location as "NE/CNW/SW" or footage from lines NE NE NE
Lease Owner Sterling Drilling Company
Lease Name Thiessen Well No. 1
Office Address Sterling, Kansas
Character of Well (completed as Oil, Gas or Dry Hole) Dry Hole
Date well completed May 30, 1956
Application for plugging filed May 30, 1956
Application for plugging approved May 30, 1956
Plugging commenced May 30, 1956
Plugging completed May 30, 1956
Reason for abandonment of well or producing formation

If a producing well is abandoned, date of last production 19
Was permission obtained from the Conservation Division or its agents before plugging was commenced? Yes

Name of Conservation Agent who supervised plugging of this well Ruel Durkee
Producing formation Depth to top Bottom Total Depth of Well 3245 Feet
Show depth and thickness of all water, oil and gas formations.

OIL, GAS OR WATER RECORDS

CASING RECORD

FORMATION	CONTENT	FROM	TO	SIZE	PUT IN	PULLED OUT
				8-5/8	200	

Describe in detail the manner in which the well was plugged, indicating where the mud fluid was placed and the method or methods used in introducing it into the hole. If cement or other plugs were used, state the character of same and depth placed, from feet to feet for each plug set.

Filled hole with heavy mud. Set Halliburton plug at 190' with 1/3 sack hulls and 15 sacks cement. Set second plug at 30' with 1/3 sacks hulls and 5 sacks cement to bottom of cellar.

6-7-1956

(If additional description is necessary, use BACK of this sheet)

Name of Plugging Contractor Sterling Drilling Co.
Address Sterling, Kansas

STATE OF KANSAS, COUNTY OF RICE, ss.
F. A. Wuellner (employee of owner) or (owner or operator) of the above-described

well, being first duly sworn on oath, says: That I have knowledge of the facts, statements, and matters herein contained and the log of the above-described well as filed and that the same are true and correct. So help me God.

(Signature)

Sterling, Kansas

(Address)

SUBSCRIBED AND SWORN TO before me this 6th day of May, 1956


My Commission Expires Jan. 22, 1958

My commission expires

Bernard Landermilk

Notary Public.

24-7368-S 3-53-20M

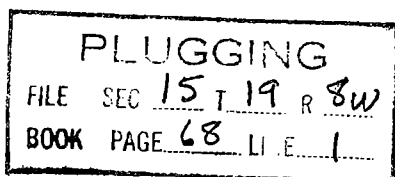

STERLING DRILLING COMPANY
Sterling, Kansas

WELL LOG-----THIESSEN #1

Location: NE NE NE, Section 15-19S-8W,
Rice County, Kansas

OWNER: Sterling Drilling Company - N. Appleman Company
ROTARY DRILLING CONTRACTOR: Sterling Drilling Company

COMMENCED: 5-20-56 (w.r.)
COMPLETED: 5-30-56 (w.r.)

TOTAL DEPTH: 3245' T.D.

LOG

CASING RECORD

0-60	Shale & Shells
60-205	Sand & Shale
205-1240	Shale & Shells
1240-2490	Shale & Limestone
2490-2585	Limestone
2585-2700	Shale & Limestone
2700-2725	Limestone
2725-2840	Shale & Sand
2840-3150	Limestone
3150-3200	Limestone, Shale & Sand
3200-3245	Limestone T.D.

Ran 200' of 8-5/8" casing set with
150 sacks cement, 2% calcium chloride.

PRODUCTION

Plugged & Abandoned

PLUGGING

FILE SEC 15 T 19 R 8W
BOOK PAGE 68 LINE 1

RELEASED
STATE BOARD OF LAND COMMISSIONERS

JUN 11 1956

CONSERVATION DIVISION
Wichita, Kansas