

STATE OF KANSAS
STATE CORPORATION COMMISSION

Give All Information Completely
Make Required Affidavit
Mail or Deliver Report to:

Conservation Division
State Corporation Commission
800 Bitting Building
Wichita, Kansas


WELL PLUGGING RECORD

OR

FORMATION PLUGGING RECORD

Strike out upper line
when reporting plug-
ging off formations.

NORTH

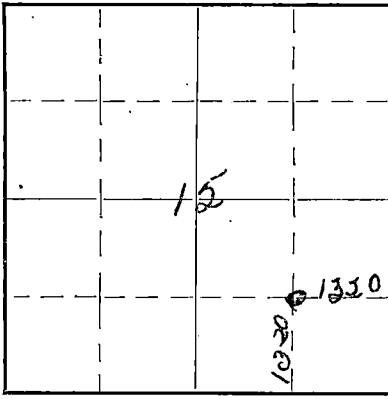

Locate well correctly on above
Section Plat

Rice County. Sec. 15 Twp. 19 Rge. 8 (W)

Location as "NE 1/4 NW 1/4 SW 1/4" or footage from lines 1320 ft north 1320 ft west.

Lease Owner Cities Service Gas Co.

Lease Name Hill Well No. 1

Office Address Chase Kansas

Character of Well (Completed as Oil, Gas or Dry Hole) Dry hole

Date, well completed Nov-14- 1940

Application for plugging filed Nov-15- 1940

Application for plugging approved 193

Plugging Commenced Nov-15- 1940

Plugging Completed Nov-21 1940

Reason for abandonment of well or producing formation Hole full of

Water

If a producing well is abandoned, date of last production 193

Was permission obtained from the Conservation Division or its agents before plugging was com-
menced? Yes

Name of Conservation Agent who supervised plugging of this well Rural Durkey

Producing formation Arbuckle lime Depth to top 3317 Bottom 3325 Total Depth of Well 3325 Feet.

Show depth and thickness of all water, oil and gas formations.


OIL, GAS OR WATER RECORDS

CASING RECORD

Formation	Content	From	To	Size	Put In	Pulled Out
Arbuckle lime	Water	3317	3325	10 3/4 7" O.D.	213 3318	none. 1251

Describe in detail the manner in which the well was plugged, indicating where the mud fluid was placed and the method or methods used in introducing it into the hole. If cement or other plugs were used, state the character of same and depth placed, from _____ feet to _____ feet for each plug set.

hole was cemented from 3325-3287 ft.
Mudded with heavy mud (slumped in) to 213 ft.
Hole bridged with dry hole plug at 313 ft.
Cemented with 12 sacks cement. Mudded to 10 ft.
Bridged with dry hole plug and cemented to bottom
of cellar. Cap welded over 10 3/4 O.D. surface pipe.

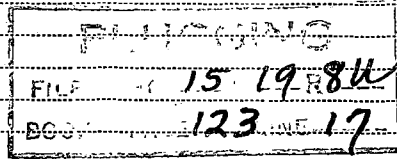

NOV 26 1940
STATE CORP. COM. CONSERV. DIV.

11-26-1940

(If additional description is necessary, use BACK of this sheet)

Correspondence regarding this well should be addressed to Cities Service Gas Co.
Address Chase Kansas

STATE OF Kansas COUNTY OF Rice, ss.
W. H. Prather (employee of owner) or (owner or operator) of the above-described well,

being first duly sworn on oath, says: That I have knowledge of the facts, statements, and matters herein contained and the log of the above-described well as filed and that the same are true and correct. So help me God.

(Signature) W. H. Prather

Box 436 Lyons Kansas (Address)

SUBSCRIBED AND SWORN to before me this 25th day of Nov., 1940

My commission expires July 31, 1943.

Notary Public.

WELL RECORD

Company Citizen Service Gas Company Well No. 1 Farm Hilt
 Location 1320' North and 1320' West of SE Corner Sec. 15 T. 19 R. 6-W
 Elevation 1755' County Rice State Kansas
 Drlg. Comm. October 18, 1940 Contractor Herndon Drilling Company
 Drlg. Comp. November 1, 1940 Acid None
 T. D. 3325' - cemented back to 3307' Initial Prod. Dry - P. & A.

CASING RECORD:

10-3/4" @ 213' cemented with 150 sacks
 7" @ 3318' cemented with 75 sacks
 Ash Grove; pulled 1251'.

FORMATION RECORD:

shale & shells 0-310
 Anhydrite 315
 shale & shells 1280
 lime 1390
 broken lime 1815
 broken lime & shale 1935
 shale 2010
 shale & shells 2185
 broken lime 2230
 lime 2255
 shale & lime 2375
 shale & shells 2455
 lime 2805
 lime & shale 2870
 lime 3105
 lime broken 3195
 lime 3235
 shale & shells 3275
 lime 3280
 lime, sand & shale 3300
 lime & shale 3320
 lime cored (rec. 5') 3325

Rotary T.D. 3325 = 3325 S.L.M.

Top Lansing 2875
 Top Simpson 3287
 Top Arbuckle 3317
 Penetration 8'
 Total Depth 3325

Fillup: 2500' sulphur water in 1 hour 40 minutes.

Plugged back to 3307' with 5 sacks cement.

Perforated Simpson Sand by Lane-Kells as follows:

12 shots 3285-96
 12 shots 3287-91 1/2
 12 shots 3291 1/2-96
 12 shots 3295 1/2-3300

CYFO: 500' 0°
 1000' 0°
 1500' 0°
 2000' 0°
 2500' 0°
 3000' 0°

INDEXING
 FILE 15 19-94
 BOOK 123-17

340
 1941
 121