


STATE OF KANSAS  
 STATE CORPORATION COMMISSION  
 CONSERVATION DIVISION  
 P. O. BOX 17027  
 WICHITA, KANSAS 67217

FORM CP-4

WELL PLUGGING RECORD

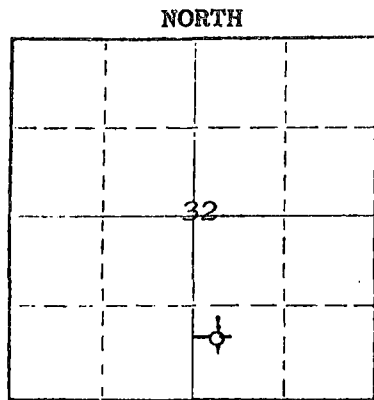

Locate well correctly on above Section Plat

Kiowa County, Sec 32 Twp 30S Rge 18W (W)  
 Location as "NE/CNWxSWx" or footage from lines NW SW SE  
 Lease Owner D. R. Lauck Oil Company, Inc. and Lee Banks  
 Lease Name Barngrover Well No. 1  
 Office Address 301 S. Broadway, Wichita, Kansas 67202  
 Character of Well (completed as Oil, Gas or Dry Hole) Dry Hole  
 Date well completed June 28, 1975  
 Application for plugging filed June 28, 1975  
 Application for plugging approved June 28, 1975  
 Plugging commenced June 28, 1975  
 Plugging completed June 28, 1975  
 Reason for abandonment of well or producing formation Dry Hole

If a producing well is abandoned, date of last production \_\_\_\_\_ 19\_\_\_\_  
 Was permission obtained from the Conservation Division or its agents before plugging was commenced? Yes

Name of Conservation Agent who supervised plugging of this well \_\_\_\_\_  
 Producing formation \_\_\_\_\_ Depth to top \_\_\_\_\_ Bottom \_\_\_\_\_ Total Depth of Well \_\_\_\_\_ Feet  
 Show depth and thickness of all water, oil and gas formations.

OIL, GAS OR WATER RECORDS				CASING RECORD		
FORMATION	CONTENT	FROM	TO	SIZE	PUT IN	FULLED OUT
		0'	261'	10-3/4"	252.86'	None
		0'	565'	8-5/8"	559.03'	None

Describe in detail the manner in which the well was plugged, indicating where the mud fluid was placed and the method or methods used in introducing it into the hole. If cement or other plugs were used, state the character of same and depth placed, from \_\_\_\_\_ feet to \_\_\_\_\_ feet for each plug set.

Spotted with 35 sacks cement at 350',  
 15 sacks at 40'. Plug and 1/2 sack  
 hulls at 40'. 2 sacks cement in rat hole.

RECEIVED  
 STATE CORPORATION COMMISSION  
 7-9-1975  
 JUL 9 1975

(If additional description is necessary, use BACK of this sheet)  
 Name of Plugging Contractor Allied Cementing Co. CONSERVATION DIVISION  
 Address Box 31, Russell, Kansas Wichita, Kansas

STATE OF KANSAS COUNTY OF SEDGWICK ss.

John D. Knightley (employee of owner) or (owner or operator) of the above-described well, being first duly sworn on oath, says: That I have knowledge of the facts, statements, and matters herein contained and the log of the above-described well as filed and that the same are true and correct. So help me God.

(Signature) [Signature]  
301 S. Broadway, Wichita, Kansas  
 (Address)

Subscribed and sworn to before me this 7th day of July, 1975

My commission expires March 12, 1979 [Signature] Notary Public.

D. R. Lauck Oil Company, Inc.  
and Lee Banks

#1 Barngrover

NW SW SE Sec. 32-30S-18W  
Kiowa County, Kansas

Commenced: June 12, 1975

Completed: June 28, 1975

Casing Record: 261' 10-3/4" Cemented with 100 sacks common  
cement, 2% Gel, 3% Calcium Chloride.  
Recemented with 133 sacks common  
cement, 4% Calcium Chloride.  
Cemented from top with 207 sacks cement.  
565' 8-5/8" Cemented with 150 sacks common  
cement, 3% Calcium Chloride.

Elevation: GL 2200; DF 2203; KB 2205 by county engineer.  
KB 2203 by Laughlin-Simmons.

Drillers Log

Clay & Shale	176
Shale	264
Red Bed	323
Gyp	346
Shale	1445
Shale & Shells	2270
Shale & Lime	2450
Lime & Shale	3035
Lime	3140
Lime & Shale	3720
Lime	4005
Shale & Lime	4105
Lime	5180 RTD

RECEIVED  
STATE CORPORATION COMMISSION

JUL 9 1975

CONSERVATION DIVISION  
Wichita, Kansas