


STATE OF KANSAS  
STATE CORPORATION COMMISSION

WELL PLUGGING RECORD

Give All Information Completely.  
Make Required Affidavit  
Mail or Deliver Report to  
Conservation Division  
State Corporation Comm.  
245 North Water  
Wichita, KS 67202

Kiowa County. Sec. 32 Twp. 30 Rge. 18 XE/W  
Location as "NE/CNW1SW1" or footage from lines  
C SW NW

Lease Owner Okmar Oil Company  
Lease Name Crowe Well No. 1  
Office Address 970 Fourth Financial Ctr. Wichita, KS 67202  
Character of Well (Completed as Oil, Gas or Dry Hole) Dry Hole

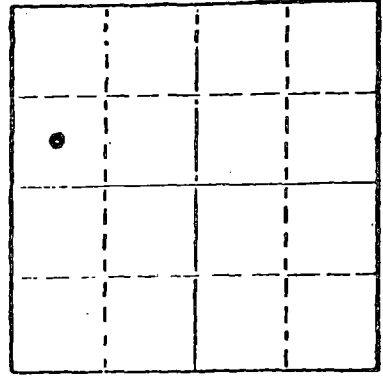

Locate well correctly on above Section Plat

Date Well completed October 8 1977  
Application for plugging filed January 25 1978  
Application for plugging approved 1978  
Plugging commenced 9:00 A.M. October 8 1977  
Plugging completed 10:00 A.M. October 8 1977  
Reason for abandonment of well or producing formation Dry

If a producing well is abandoned, date of last production 19

Was permission obtained from the Conservation Division or its agents before plugging was commenced? Yes

Name of Conservation Agent who supervised plugging of this well Bill Owen  
Producing formation Depth to top Bottom Total Depth of Well 5125  
Show depth and thickness of all water, oil and gas formations.

OIL, GAS OR WATER RECORDS

CASING RECORD

FORMATION	CONTENT	FROM	TO	SIZE	PUT IN	PULLED OUT
				12 3/4"	524'	None

Describe in detail the manner in which the well was plugged, indicating where the mud fluid was placed and the method or methods used in introducing it into the hold. If cement or other plugs were used, state the character of same and depth placed, from feet to feet for each plug set.

Plug at 520' with 50 sx.  
Plug and bridge at 40' with 35 sx.  
5 sx. Rathole

RECEIVED  
STATE CORPORATION COMMISSION

JAN 27 1978

1-27-78

(If additional description is necessary, use BACK of this sheet)

Name of Plugging Contractor Gabbert-Jones, Inc.

STATE OF Kansas COUNTY OF Sedgwick, ss.  
Don Beauchamp (employee of owner) or (owner or operator)

of the above-described well, being first duly sworn on oath, says: That I have knowledge of the facts, statements, and matters herein contained and the log of the above-described well as filed and that the same are true and correct. So help me God.

(Signature)

*Don W. Beauchamp*

970 Fourth Financial Ctr. Wichita, KS  
(Address)

SUBSCRIBED AND SWORN TO before me this 26th day of January, 1978

KAREN G. COX  
Sedgwick County, Ks.  
My Appl. Exp. 11-4-80

*Karen G. Cox*

Notary Public.

My commission expires

GABBERT-JONES, INC.  
WICHITA, KANSAS  
DRILLERS' WELL LOG

Crowe #1  
C SW NW Sec 32-30S-18W  
Kiowa County Kansas

Commenced: 9-26-77

Completed: 10-8-77

OPERATOR: OKMAR OIL CO.

Depth		Formation	Remarks
From	to		
0	35	Soil & Sand Stks	Ran 15 jts of 38# 1 3/4"
35	140	Sand-Shale	csg set @ 524' Cemented
140	300	Redbed-Shale	w/250 sks Common 2%
300	327	Rock	Gel 3% CC + 200 sks
327	2286	Shale	Common 3% CC
2286	3290	Shale-Lime	PD @ 8:05 p.m. 9-27-77
3290	3990	Lime-Shale	
3990	5125	Lime	
	5125 - TD		DRY & ABANDONED

STATE OF KANSAS )  
                                  ) SS  
COUNTY OF SEDGWICK)

I, the undersigned, being duly sworn on oath, state that the above Drillers' Well Log is true and correct to the best of my knowledge and belief and according to the records of this office.

GABBERT-JONES, INC.

*James S. Sutton II*  
JAMES S. SUTTON II

Subscribed and sworn to before me this 17th day of October, 1977.

*Elizabeth J. Edwards*  
ELIZABETH J. EDWARDS-NOTARY PUBLIC

My Commission expires February 6, 1979.

RECEIVED  
STATE CORPORATION COMMISSION

JAN 27 1978

CONSERVATION DIVISION  
Wichita, Kansas

