


STATE OF KANSAS  
STATE CORPORATION COMMISSION

WELL PLUGGING RECORD

Give All Information Completely  
Make Required Affidavit  
Mail or Deliver Report to  
Conservation Division  
State Corporation Comm.  
245 North Water  
Wichita, KS 67202

Kiowa County. Sec. 36 Twp. 30S Rge. 18W E/W  
Location as "NE/CNW $\frac{1}{4}$ SW $\frac{1}{4}$ " or footage from lines  
C NW SW

Lease Owner The Maurice L. Brown Company  
Lease Name J. C. Unruh Well No. D-2  
Office Address 200 Sutton Place, Wichita, Kans.  
Character of Well (Completed as Oil, Gas or Dry Hole)  
Dry Hole

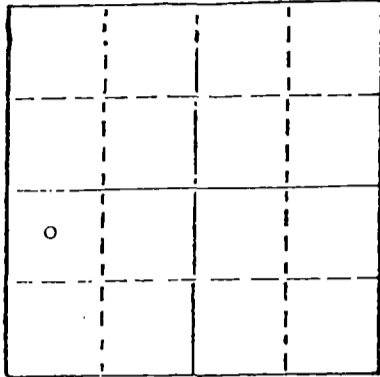

Locate well correctly on above Section Plat

Date Well completed 8-18 1979  
Application for plugging filed Verbal 8 1979  
Application for plugging approved Verbal 8 1979  
Plugging commenced 8-18 1979  
Plugging completed 8-18 1979  
Reason for abandonment of well or producing formation  
OWWO - Unable to stay in old hole

If a producing well is abandoned, date of last production  
----- 19

Was permission obtained from the Conservation Division or its agents before plugging was commenced? Yes

Name of Conservation Agent who supervised plugging of this well Bill Owens  
Producing formation None Depth to top - Bottom - Total Depth of Well 2868'  
Show depth and thickness of all water, oil and gas formations.

OIL, GAS OR WATER RECORDS

CASING RECORD

FORMATION	CONTENT	FROM	TO	SIZE	PUT IN	PULLED OUT

Describe in detail the manner in which the well was plugged, indicating where the mud fluid was placed and the method or methods used in introducing it into the hold. If cement or other plugs were used, state the character of same and depth placed, from \_\_\_\_\_ feet to \_\_\_\_\_ feet for each plug set.

TD 2868  
1st Plug @ 540' w/50 sx  
2nd plug @ 40' w/12 sx  
3 sx rathole

RECEIVED  
STATE CORPORATION COMMISSION

JAN 17 1980  
1-17-80

CONSERVATION DIVISION  
Wichita, Kansas

(If additional description is necessary, use BACK of this sheet)

Name of Plugging Contractor Gabbert-Jones

STATE OF KANSAS COUNTY OF SEDGWICK, ss.  
Vern Haselhorst (employee of owner) or (owner or operator)  
of the above-described well, being first duly sworn on oath, says: That I have knowledge of the facts, statements, and matters herein contained and the log of the above-described well as filed and that the same are true and correct. So help me God.

(Signature) Vern Haselhorst  
Vern Haselhorst  
200 Sutton Place, Wichita, Kans. 67202  
(Address)

SUBSCRIBED AND SWORN TO before me this 4th day of January, 1980

Appointment  
My commission expires July 29, 1981

Marjorie P. Jennings  
Marjorie P. Jennings Notary Public.

GABBERT-JONES, INC.  
WICHITA, KANSAS  
DRILLERS' WELL LOG

J. C. Unruh "D" #2 OWWO  
C-NW-SW Sec 36-30S-18W  
Kiowa County, Ks.

Old Information:

Operator: Petroleum, Inc.

Commenced: 1-10-71  
Completed: 1-28-71  
TD 5125

New Information:

Operator: Maurice L. Brown Co.

Commenced: 8-12-79  
Completed: 8-18-79  
TD 2868

From	Depth to	Formation	Remarks
0	1430	Cement	Ran 535' of 8 5/8" csg
1430	2290	Shale	Cemented w/300 sks Cement
2290	2391	Lime-Shale	(was Petroleum, Inc.
2391	2440	Shale	#1 Unruh "F")
2440	2650	Lime-Shale	
2650	2715	Shale	
2715	2868	Lime-Shale	
	2868 - TD		PLUGGED & ABANDONED

STATE OF KANSAS )  
                          ) SS  
COUNTY OF SEDGWICK)

I, the undersigned, being duly sworn on oath, state that the above Drillers' Well Log is true and correct to the best of my knowledge and belief and according to the records of this office.

GABBERT-JONES, INC.

*James S. Sutton II*  
JAMES S. SUTTON II

Subscribed and sworn to before me this 7th day of September, 1979.

My Commission expires February 6, 1983.

RECEIVED  
STATE CORPORATION COMMISSION  
ELIZABETH J. EDWARDS-NOTARY PUBLIC  
JAN 17 1980  
CONSERVATION DIVISION  
Wichita, Kansas

