


WELL PLUGGING RECORD

Give All Information Completely
Make Required Affidavit
Mail or Deliver Report to:
Conservation Division
State Corporation Commission
211 No. Broadway
Wichita, Kansas

NORTH

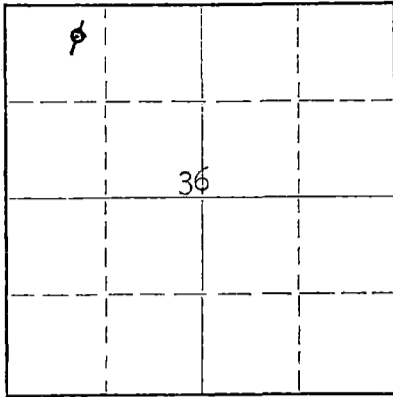

Locate well correctly on above
Section Plat

Barton County. Sec. 36 Twp. 20S Rge. 12W (E) (W)
Location as "NE/CNW&SW" or footage from lines NE/4 NW/4 NW/4
Lease Owner Birmingham-Bartlett Drilling Co., et al
Lease Name Panning "A" Well No. 1
Office Address 300 Kaufman Building, Wichita 2, Kansas
Character of Well (completed as Oil, Gas or Dry Hole) Oil Well
Date well completed April 8 1952
Application for plugging filed January 30 1957
Application for plugging approved February 8 1957
Plugging commenced February 26 1957
Plugging completed March 6 1957
Reason for abandonment of well or producing formation Production depleted

If a producing well is abandoned, date of last production January 3 1957
Was permission obtained from the Conservation Division or its agents before plugging was commenced? Yes

Name of Conservation Agent who supervised plugging of this well Russell Brundege
Producing formation Arbuckle Depth to top 3367 Bottom 3418 Total Depth of Well 3418 Feet
Show depth and thickness of all water, oil and gas formations.

OIL, GAS OR WATER RECORDS

CASING RECORD

FORMATION	CONTENT	FROM	TO	SIZE	PUT IN	PULLED OUT
		0	258'	8-5/8"	262'	None
		0	3370'	5-1/2"	3369'	2517.75'

Describe in detail the manner in which the well was plugged, indicating where the mud fluid was placed and the method or methods used in introducing it into the hole. If cement or other plugs were used, state the character of same and depth placed, from 3418 feet to surface feet for each plug set.

Hole filled with sand from 3418 to 3355; five sacks of cement placed in hole with dump bailer, and casing pulled from hole. Thereafter Halliburton cementing trucks pumped in 25 sacks of mud followed by plug, pumped down with 70 sacks of cement. Plugging Complete.

RECEIVED
STATE CORPORATION COMMISSION

MAR 15 1957

Name of Plugging Contractor Barnes and Sons Pipe Pulling Co.
Address Russell, Kansas
CONSERVATION DIVISION
Wichita, Kansas

STATE OF KANSAS COUNTY OF SEDGWICK ss.
Chas. H. Keevert, Production Supt. for Birmingham-Bartlett Drilling Co., part owner & operator

well, being first duly sworn on oath, says: That I have knowledge of the facts, statements, and matters herein contained and the log of the above-described well as filed and that the same are true and correct. So help me God.

(Signature) Chas. H. Keevert
N Hutchinson, Kans
(Address)

SUBSCRIBED AND SWORN TO before me this 13th day of March, 1957.

Vivian J. Ginger
Notary Public.

My commission expires November 29, 1958.

PLUGGING
FILE SEC 36 T. 20 R. 12W
BOOK PAGE 139 LINE 19

PANNING NO. 1 WELL

LOCATION: NE $\frac{1}{4}$ NW $\frac{1}{4}$ NW $\frac{1}{4}$ 36-20S-12W
Barton County, Kansas

SPUDDED: 3-30-52

OPERATOR: Birmingham-Bartlett Drilling Co.

COMPLETED: 4-8-52

CONTRACTOR: Birmingham-Bartlett Drilling Co.

SURFACE CASING: 8-5/8" casing cemented at 258' with
200 sacks cement at 2 c.c.

OIL STRING: 5 $\frac{1}{2}$ " 14# casing cemented at 3369' with
100 sacks cement.

L O G

(Figures indicate bottom of formation)

0 to 175	Sand
240	Sand and shale
258	Shale
400	Shale and red bed
585	Red rock
610	Anhydrite
1490	Shale and shells
1760	Lime
2050	Lime and shale
2640	Shale and shells
3030	Lime
3090	Shale and shells
3130	Shale
3135	Brown lime
3370	Lime
3370	Total depth.

The undersigned Richard Hindery of the Birmingham-Bartlett Drilling Co. hereby certifies that the above is a true and correct log of the formations encountered in drilling the Panning No. 1 well as shown on the daily drilling reports.

BIRMINGHAM-BARTLETT DRILLING CO.

BY Richard Hindery

Subscribed and sworn before me
this 10th day of April, 1952.

Thomas L. Genger
Notary Public

My commission expires November 29, 1954.

RECEIVED
STATE OF KANSAS COMMISSION

MAR 15 1957

CONSERVATION DIVISION
Topeka, Kansas

PLUGGING	
FILE SEC.	36 T 20 R 12 W
BOOK PAGE	139 LINE 19