


STATE OF KANSAS
STATE CORPORATION COMMISSION

WELL PLUGGING RECORD

Give All Information Completely
Make Required Affidavit
Mail or Deliver Report to:
Conservation Division
State Corporation Commission
800 Bitting Building
Wichita, Kansas

Barton County. Sec. 36 Twp. 20S Rge. (E) 12 (W)
Location as "NE/CNW/SW" or footage from lines NE SW NE
Lease Owner Derby Drilling Company
Lease Name Musenberg Well No. 1
Office Address 352 North Broadway, Wichita 2, Kansas
Character of Well (completed as Oil, Gas or Dry Hole) Dry Hole
Date well completed October 6, 1952
Application for plugging filed October 6, 1952
Application for plugging approved October 7, 1952
Plugging commenced October 6, 1952
Plugging completed October 6, 1952
Reason for abandonment of well or producing formation - - -

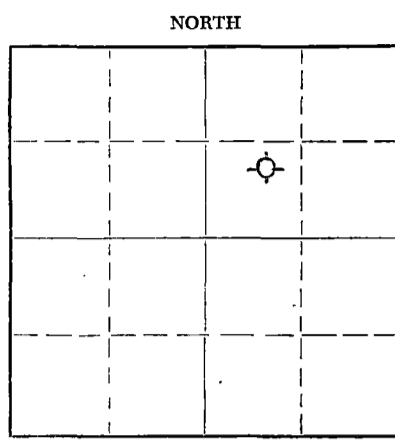

Locate well correctly on above
Section Plat

If a producing well is abandoned, date of last production - - - 19
Was permission obtained from the Conservation Division or its agents before plugging was commenced? Yes

Name of Conservation Agent who supervised plugging of this well C. D. Stough, Box 207, Great Bend, Kansas
Producing formation --- Depth to top --- Bottom --- Total Depth of Well 3430 Feet
Show depth and thickness of all water, oil and gas formations.

OIL, GAS OR WATER RECORDS

CASING RECORD

FORMATION	CONTENT	FROM	TO	SIZE	PUT IN	PULLED OUT
				8-5/8	280'	None

Describe in detail the manner in which the well was plugged, indicating where the mud fluid was placed and the method or methods used in introducing it into the hole. If cement or other plugs were used, state the character of same and depth placed, from feet to feet for each plug set.

Filled hole with mud to 270'. Set plug and cemented with 20 sacks. Filled hole with mud to 40'. Set plug and cemented with 10 sacks.

RECEIVED
STATE CORPORATION COMMISSION
OCT 10 1952 10-10-1952
CONSERVATION DIVISION
Wichita, Kansas

(If additional description is necessary, use BACK of this sheet)
Name of Plugging Contractor Rocket Drilling Company
Address 352 North Broadway, Wichita 2, Kansas

STATE OF Kansas, COUNTY OF Sedgwick, ss.
B. W. Burks (employee of owner) ~~or (owner or operator)~~ of the above-described well, being first duly sworn on oath, says: That I have knowledge of the facts, statements, and matters herein contained and the log of the above-described well as filed and that the same are true and correct. So help me God.

(Signature) [Signature]
352 North Broadway, Wichita 2, Kansas
(Address)

SUBSCRIBED AND SWORN TO before me this 8th day of October, 1952

My commission expires 12-3-55
Barbara Hewley
Notary Public.

PLUGGING
FILE SEC 36 T 20 R 12 S 4
BOOK PAGE 50 LINE 16

ROCKET DRILLING COMPANY
 352 North Broadway
 Wichita 2, Kansas

Derby Drilling Company, Etal
 352 North Broadway
 Wichita 2, Kansas

#1 Musenberg
 NE SW NE, 36-20-12W
 Barton County, Kansas

Elevation: 1816 R.B.
 Spudded: September 27, 1952
 Rotary Completed: October 6, 1952
 Cable Tools Completed:
 Acid Treatment:
 Initial Production: Dry & Abandoned
 Contractor: Rocket Drilling Company

CASING RECORD

280' 8-5/8" O. D. 24# Seamless Casing Cemented W/175 Sacks Cement.
 5-1/2" None.

DRILLERS LOG

Sand	0 to 225	Lime & Shale	1895 to 2240
Blue Shale	235	Shale & Lime	2673
Red Shale	280	Shale	2725
Shale & Sand	587	Lime	3013
Anhydrite	605	Shale	3115
Shale & Shells	1108	Shale & Lime	3194
Salt, Shale & Shells	1565	Lime	3370
Lime & Shale	1810	Lime & Shale	3404
Lime	1863	Shale	3409
Sand	1875	Arbuckle	3430 TD
Lime	1895		

STATE OF KANSAS) ss:
 SEDGWICK COUNTY)

I hereby certify that to the best of my knowledge and belief,
 the foregoing log is true and correct.

RECEIVED
 STATE CORPORATION COMMISSION
 OCT 10 1952
 CONSERVATION DIVISION

ROCKET DRILLING COMPANY

By: *[Signature]*

Subscribed and sworn to before me, a Notary Public, in and for
 the State and County aforesaid this 8th day of October, 1952.

My Commission Expires: 12-3-55

[Signature]
 Notary Public

