

WELL PLUGGING RECORD

Give All Information Completely
Make Required Affidavit
Mail or Deliver Report to:
Conservation Division
State Corporation Commission
211 No. Broadway
Wichita, Kansas

Barton County, Sec. 36 Twp. 20S Rge. (E) 12W (W)

Location as "NE/CNW/SW" or footage from lines C W¹/₂ SW¹/₄ SE¹/₄

Lease Owner Birmingham-Bartlett Drilling Co.

Lease Name Alexian Well No. 5

Office Address 300 Kaufman Bldg., Wichita, Kansas, 67202

Character of Well (completed as Oil, Gas or Dry Hole) Oil Well

Date well completed September 23, 1955

Application for plugging filed March 8, 1966

Application for plugging approved March 9, 1966


Plugging commenced March 14, 1966

Plugging completed March 22, 1966

Reason for abandonment of well or producing formation Production declined to a point where well no longer economical to operate.

If a producing well is abandoned, date of last production February 15, 1966

Was permission obtained from the Conservation Division or its agents before plugging was commenced? Yes

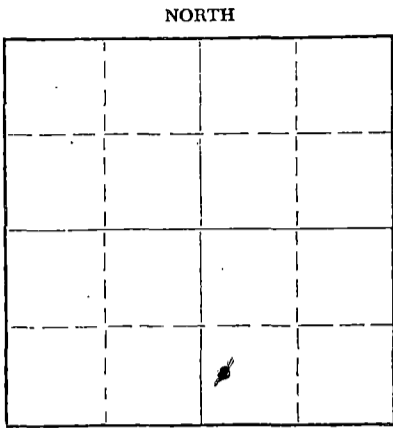

Locate well correctly on above Section Plat

Name of Conservation Agent who supervised plugging of this well Donald Truan

Producing formation Arbuckle Depth to top 3400' Bottom _____ Total Depth of Well 3462 Feet

Show depth and thickness of all water, oil and gas formations.

OIL, GAS OR WATER RECORDS

CASING RECORD

FORMATION	CONTENT	FROM	TO	SIZE	PUT IN	PULLED OUT
		0	256'	8-5/8"	256'	None
		0	3405'	5-1/2"	3403'	2651'

Describe in detail the manner in which the well was plugged, indicating where the mud fluid was placed and the method or methods used in introducing it into the hole. If cement or other plugs were used, state the character of same and depth placed, from _____ feet to _____ feet for each plug set.

3462' - 3390' - Sand
 3390' - 3360' - 5 Sacks Cement
 3360' - 250' - Mud
 250' - 240' - Rock Bridge
 240' - 216' - 8 Sacks Cement
 216' - 165' - 17 Sacks Cement
 165' - 40' - Mud
 40' - 30' - Rock Bridge
 30' - Base - 10 Sacks Cement

RECEIVED
STATE CORPORATION COMMISSION

MAR 20 1966

WICHITA, KANSAS

3-28-1966

(If additional description is necessary, use BACK of this sheet)

Name of Plugging Contractor Santa-Fe Pipe & Supply, Inc
Address P.O. Box 562, Great Bend, Kansas

STATE OF KANSAS COUNTY OF SEDGWICK, ss.
Chas. H. Keevert, Prod. Supt. of Birmingham-Bartlett Drilling Co. (employee of owner) or (owner or operator) of the above-described well, being first duly sworn on oath, says: That I have knowledge of the facts, statements, and matters herein contained and the log of the above-described well as filed and that the same are true and correct. So help me God.

(Signature) Chas. H. Keevert
Chas. H. Keevert
Route 1, 1806 Tracy Lane, Hutchinson, Ks.
(Address)

SUBSCRIBED AND SWORN TO before me this 25th day of March, 19 66.

My commission expires November 29, 1966.

Vivian F. Yinger
Vivian F. Yinger Notary Public.

ALEXIAN NO. 5 WELL

LOCATION: Center W/2 SW/4 SE/4
Section 36-20S-12W
Barton County, Kansas

SPUDED: 9-11-55
COMPLETED: 9-18-55

OWNERS, OPERATOR
and CONTRACTOR: Birmingham-Bartlett Drilling Co.
300 Kaufman Bldg.
Wichita 2, Kansas

SURFACE CASING: 8-5/8" casing set at 257' with
175 sacks cement

OIL STRING: 5-1/2" 14# 8rd thd J-55 smls casing
set at 3403' with 100 sacks cement

RECEIVED
STATE COMMISSION

MAR 9 1966

LOG

(Figures indicate bottom of formation.)

0 -	257	Sand and clay
	550	Sand, red bed, and shale
	593	Red bed and shale
	625	Anhydrite
	1275	Shale and red bed
	1517	Shale and shells
	1548	Broken lime
	1970	Shale and lime
	1995	Shale and shells
	3058	Lime and shale
	3150	Shale
	3284	Lime and shale
	3345	Lime
	3392	Lime and shale
	3405	Conglomerate and lime
	3405	Rotary Total Depth

The undersigned, Richard Hindery, one of the partners of Birmingham-Bartlett Drilling Co., hereby certifies that the above is a true and correct log of the formations encountered in drilling the Alexian No. 5 Well as shown in the daily drilling reports.

BIRMINGHAM-BARTLETT DRILLING CO.

By Richard Hindery

Subscribed and sworn to before me
this 20th day of September, 1955.

Beverly Larson
Notary Public

My commission expires October 2, 1958.