


WELL PLUGGING RECORD

Give All Information Completely
Make Required Affidavit
Mail or Deliver Report to:
Conservation Division
State Corporation Commission
211 No. Broadway
Wichita, Kansas

Rice County. Sec. 31 Twp. 18S Rge. 6 (E) (W)

Location as "NE/CNW/SW" or footage from lines SE SE SW
Lease Owner Dunne-Gardner Drilling Co., Inc.
Lease Name Mabry Well No. 1
Office Address 300 Schweiter Building, Wichita, Kansas
Character of Well (completed as Oil, Gas or Dry Hole) Dry Hole
Date well completed July 5, 19 64
Application for plugging filed 19
Application for plugging approved 19
Plugging commenced July 5, 19 64
Plugging completed July 5, 19 64
Reason for abandonment of well or producing formation dry hole

NORTH

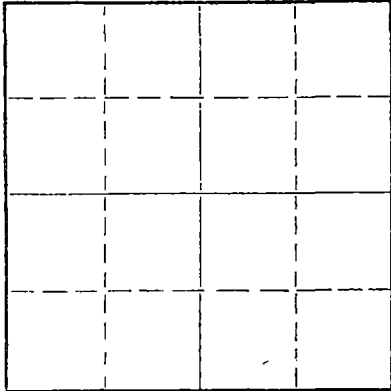

Locate well correctly on above
Section Plat

If a producing well is abandoned, date of last production 19
Was permission obtained from the Conservation Division or its agents before plugging was commenced? yes

Name of Conservation Agent who supervised plugging of this well Gilbert Toman
Producing formation Depth to top Bottom Total Depth of Well 3250 Feet
Show depth and thickness of all water, oil and gas formations.

OIL, GAS OR WATER RECORDS

CASING RECORD

FORMATION	CONTENT	FROM	TO	SIZE	PUT IN	PULLED OUT
Surface Pipe		-0-	217	8-5/8	6-29-64	None

Describe in detail the manner in which the well was plugged, indicating where the mud fluid was placed and the method or methods used in introducing it into the hole. If cement or other plugs were used, state the character of same and depth placed, from feet to feet for each plug set.

Fill hole with heavy mud to 220' from surface. Set plug, 1/4 sack hulls and 20 sacks cement. Mud to 40' from surface, set plug, 1/4 sack hulls and 10 sacks of cement. Put 2 sacks cement in rat hole.

RECEIVED
STATE CORPORATION COMMISSION

JUL 7 1964
7-7-1964

CONSERVATION DIVISION
Wichita, Kansas

(If additional description is necessary, use BACK of this sheet)

Name of Plugging Contractor
Address

STATE OF KANSAS, COUNTY OF Sedgwick, ss.
Don Gardner

(employee of owner) (owner or operator) of the above-described well, being first duly sworn on oath, says: That I have knowledge of the facts, statements, and matters herein contained and the log of the above-described well as filed and that the same are true and correct. So help me God.

(Signature) [Signature]
300 Schweiter Building, Wichita, Kansas
(Address)

SUBSCRIBED AND SWORN TO before me this 6th day of July, 19 64

My commission expires November 9, 1965
Marilyn E. Fox Notary Public.

69

DRILLER'S LOG

OPERATOR: Dunne-Gardner Drilling Co., Inc.
 300 Schweiter Building, Wichita, Kansas

CONTRACTOR: Dunne-Gardner Drilling Co., Inc. ✓

LEASE: Mabry ✓

WELL: No. 1 ✓

LOCATION: SE SE SW Section 31-18S-6W ✓
 Rice County, Kansas

DATE COMMENCED: June 29, 1964

DATE COMPLETED: July 5, 1964

TOTAL DEPTH: 3250'

CASING: Set 8-5/8" surface pipe at 217' with 175 sacks
 of cement.

<u>FROM</u>	<u>TO</u>	
0	218	Shale and Pyrite
218	570	Blue Shale
570	950	Shale and Shells
950	2855	Lime and Shale
2855	2912	Lime
2912	3040	Lime and Chert
3040	3170	Shale
3170	3250	Lime
3250		Total Depth

RECEIVED
 STATE CORPORATION COMMISSION

AUG 17 1964

CONSERVATION DIVISION
 Wichita, Kansas

I certify the above to be true and correct to the best of my knowledge and belief.

DUNNE-GARDNER DRILLING CO., INC.

By Don Gardner
 Don Gardner

Subscribed and sworn to before me this 20th day of July, 1964.

Marilyn E. Fox
 Marilyn E. Fox, Notary Public

My Commission Expires:
 November 9, 1965