

STATE OF KANSAS  
STATE CORPORATION COMMISSION

WELL PLUGGING RECORD


OR

FORMATION PLUGGING RECORD

Strike out upper line when reporting plugging off formations.

Give All Information Completely  
Make Required Affidavit  
Mail or Deliver Report to:  
Conservation Division  
State Corporation Commission  
800 Biting Building  
Wichita, Kansas

NORTH

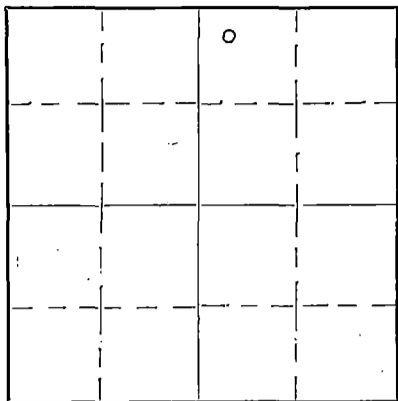

Locate well correctly on above Section Plat

Rice County. Sec. 28. Twp. 18. Rge. 6 (E) (W)  
Location as "NE 1/4 NW 1/4 SW 1/4" or footage from lines. NE 1/2 - 440' from No. line; 440' from W. Line  
Lease Owner Holl and Ackley  
Lease Name Wilkins  
Office Address Wichita, Kansas.  
Character of Well (completed as Oil, Gas or Dry Hole)  
Date, well completed May 12, 1934  
Application for plugging filed May 16, 1934  
Application for plugging approved May 17, 1934  
Plugging Commenced June 1st, 1934  
Plugging Completed June 6th, 1934  
Reason for abandonment of well or producing formation Dry

If a producing well is abandoned, date of last production 193  
Was permission obtained from the Conservation Division or its agents before plugging was commenced?

Name of Conservation Agent who supervised plugging of this well Ruel Durkee  
Producing formation None Depth to top Bottom Total Depth of Well Feet  
Show depth and thickness of all water, oil and gas formations.

OIL, GAS OR WATER RECORDS


CASING RECORD

Formation	Content	From	To	Size	Put In	Pulled Out
Lime		3246	3295	5-1/2"	3285	2943' 8"
Lime		165	205	10"	204	

Describe in detail the manner in which the well was plugged, indicating where the mud fluid was placed and the method or methods used in introducing it into the hole. If cement or other plugs were used, state the character of same and depth placed, from feet to feet for each plug set.

Hole cemented from 3514' to 3285'. 5-1/2" O.D. Casing set at 3285', cemented w/ 75 sacks cement. Cement plug in top of casing at 3000'. Hole filled with mud from 3000' to within 200' of top. Set bridge at 200' and cemented with 10 sacks of cement. Hole filled with mud to 5' of top of surface pipe. The Surface pipe was cemented w/ 150 sacks cement. Cement plug placed in top of surface pipe.

28 18 6W  
103 LINE 31

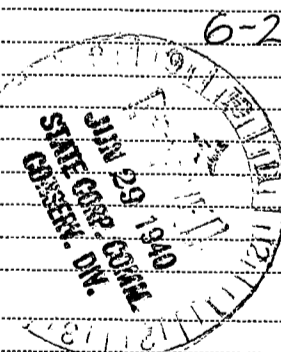

6-29-1940

(If additional description is necessary, use BACK of this sheet)

Correspondence regarding this well should be addressed to F. G. Holl,  
Address 4121 E. English St., Wichita, Ks.

STATE OF Kansas, COUNTY OF Sedgwick, ss.  
Leo V. Wentworth, 1/4 int. owner as copartner of W.W.W. Drilling Co. who owns 1/4 int in being first duly sworn on oath, says: That I have knowledge of the facts, statements, and matters herein contained and the log of the above-described well as filed and that the same are true and correct. So help me God.

(Signature) Leo V. Wentworth  
Clearwater, Ks.  
(Address)

SUBSCRIBED AND SWORN to before me this 29 day of June, 1940.

My commission expires March 4, 1944.



Notary Public.

HOLL AND ACKLEY, ET AL.,  
WELBINS WELL NO. 1:

Sec. 28, Twp. 18 S., Range 6 W.,  
NW Cor. NE1/4

Total depth 3514 feet.  
Comm. Apr. 3-1940 - started rigging up.  
Comp. May 2-1940.

County, Rice  
Production: Dry.

Contractor - R. H. W. DRILLING COMPANY

CASING:

10" 294' 10" Cemented with 150 sacks cement.  
5 1/2" 3285' Cemented with 75 Sacks. 2943' 8" pulled.

Figures Indicate Bottom of Formations:

surface clay	30	lime	2905
sand rock	60	hard lime	2933
sand and shale	115	lime	2937
sand	140	shale	2944
shale	165	lime	2962
sand and lime	205	hard lime	2967
shale	221	rough broken lime	2969
shale and red bed	292	lime break	2973
red rock and bed gray shale	630	sandy lime	2982
shale	725	porous lime	3000
salt	690	lime	3052
shale	1000	broken shale and lime	3087
shale and hard lime	1115	hard shale and lime	3100
salt	1130	brown shale & lime	3109
shale and lime	1245	lime	3124
broken lime	1370	lime, streaks shale	3160
shale and broken lime	1460	broken shale and lime	3169
lime	1575	lime	3211
shale and lime	1590	lime broken (show of oil)	3232
broken lime	1620	lime	3246
shale	1700	broken shale & lime	3295
broken lime	1734	red shale & dark shale, broken lime	3308
shale	1745	shale and lime shells	3341
broken lime	1827	broken shale & shells	3355
shale and lime shells	1952	conglomerate	3373
broken lime and shale	2090	conglomerate - cherty	3377
hard lime and shale	2100	chert	3383
hard lime and shale	2155	shale & lime shells	3395
hard shale	2172	various shales	3407
lime	2187	chert	3417
shale and lime	2195	broken chert	3421
shale	2222	chert	3428
hard shale and shells	2265	broken formation	3454
lime	2280	chert	3475
hard shale	2309	broken chert	3484
sticky shale	2350	hard lime	3500
broken lime	2375	lime	3514
shale	2385		
sandy lime	2400		
(slate) hard shale	2410		
lime	2429		
hard shale (slate)	2450		
hard shale	2455		
lime	2524		
hard shale (slate)	2540		
lime	2565		
lime and shale	2590		
hard shale and lime shells	2626		
lime	2673		
hard shale (slate)	2657		
lime	2700		
shale	2710		
broken lime and shale	2740		
sand	2755		
sandy shale	2784		
hard shale and lime shells	2810		
lime	2815		
hard shale and lime shells	2850		
hard shale	2860		
brown shale and lime	2874		

FILE NO. 28 18 6 W  
BOOK PAGE 103 LINE 31

