

STATE OF KANSAS
STATE CORPORATION COMMISSION

Give All Information Completely
Make Required Affidavit
Mail or Deliver Report to:
Conservation Division
State Corporation Commission
800 Bittner Building
Wichita, Kansas

WELL PLUGGING RECORD

Rice

County, Sec. 19 Twp. 18S Rge. 6W (W)

Location as "NE/CNW/SW" or footage from lines NE NE NW

Lease Owner E. H. Riggs

Lease Name Habiger "B" Well No. 1

Office Address 408 Rule Building - Wichita, Kansas

Character of Well (completed as Oil, Gas or Dry Hole) DRY HOLE

Date well completed AUG 12 19 55

Application for plugging filed AUG 22 19 55

Application for plugging approved AUG 23 19 55


Plugging commenced September 6 19 55

Plugging completed September 8 19 55

Reason for abandonment of well or producing formation D+A.

If a producing well is abandoned, date of last production 19

Was permission obtained from the Conservation Division or its agents before plugging was commenced? Yes

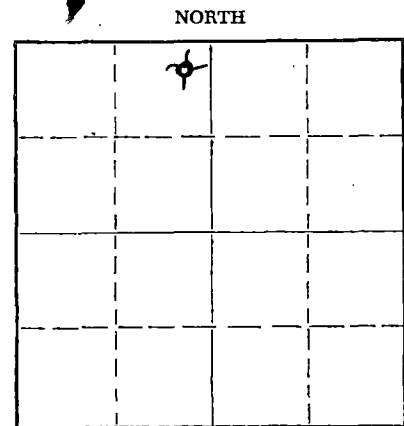

Locate well correctly on above Section Plat

Name of Conservation Agent who supervised plugging of this well Ruel Durkee

Producing formation _____ Depth to top _____ Bottom _____ Total Depth of Well 3298 Feet

Show depth and thickness of all water, oil and gas formations.

OIL, GAS OR WATER RECORDS

CASING RECORD

FORMATION	CONTENT	FROM	TO	SIZE	PUT IN	PULLED OUT
				8-5/8"	191'	None
				5-1/2"	3224'	2521'
				Hole was plugged back to 3171' and casing perforated from 3165' to 3168'.		

Describe in detail the manner in which the well was plugged, indicating where the mud fluid was placed and the method or methods used in introducing it into the hole. If cement or other plugs were used, state the character of same and depth placed, from _____ feet to _____ feet for each plug set.

Filled the hole with sand from 3171' to 3155' and ran 6 sacks of cement. Mudded the hole to 190', set a 10' rock bridge and ran 15 sacks of cement at 180'. Mudded the hole to 18' and ran 5 sacks of cement on top. Plugging compl.

(If additional description is necessary, use BACK of this sheet)

Name of Plugging Contractor West Supply Co., Inc.

Address Chase, Kansas

STATE OF KANSAS, COUNTY OF SEDGWICK, ss.

E. H. Riggs (employee of owner) or (owner or operator) of the above-described well, being first duly sworn on oath: That I have knowledge of the facts, statements, and matters herein contained and the log of the above-described well as filed and that the same are true and correct. So help me God.

(Signature)

E. H. Riggs

408 Rule Building, Wichita, Kansas (Address)

SUBSCRIBED AND SWORN TO before me this 13th day of September, 1955

My commission expires March 3, 1958

Eva L. Murray Notary Public.

RECEIVED STATE CORPORATION COMMISSION

SEP 16 1955

CONSERVATION DIVISION Wichita, Kansas

9-16-1955

PLUGGING FILE SEC 19 T 18 R 6W BOOK PAGE 144 LINE 27

ROTARY DRILLING LOG

OPERATOR: Riggs & Schafer
Haberger No. 1
NE NE NW Sec. 19-18-6W
Rice County, Kansas

CONTRACTOR: Prime Drilling Company
COMM: 8/2/55
COMP: 8/12/55

Formations:

Clay	40'
Shale & Shells	950'
Anhydrite	990'
Lime & Shale	1490'
Lime with Shale Breaks	1660'
Lime & Shale	2732'
Lime	2815'
Lime & Shale	2925'
Lime	3149'
Shale Conglomerage	3182'
Conglomerate	3215'
Shale	3297'
Total Depth	3298'

Remarks: Set 8-5/8" surface casing at 191' with 150 sacks Pozmix, 3 sacks C.C.

Set 5-1/2" casing at 3224' with 100 sacks Pozmix.

We certify that the above log is true and correct to the best of our knowledge and belief.

PRIME DRILLING COMPANY

R.R. McNicol

R. R. McNicol

Duba

PLUGGING
 FILE SEC 19 T 18 R 6W
 BOOK PAGE 44 LINE 27

RECEIVED
 STATE CORPORATION COMMISSION
 AUG 23 1955
 CONSERVATION DIVISION
 Wichita, Kansas

RECEIVED
 STATE CORPORATION COMMISSION
 AUG 23 1955
 CONSERVATION DIVISION
 Wichita, Kansas